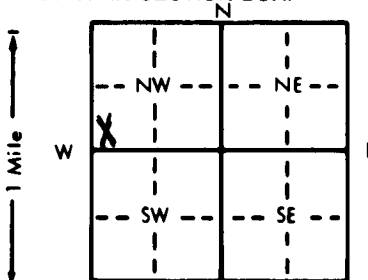


1 LOCATION OF WATER WELL:		Fraction		Section Number		Township Number		Range Number	
County: Stevens		SW 1/4 SW 1/4 NW 1/4		7		T 35 S		R 37 E	
Distance and direction from nearest town or city street address of well if located within city? From Liberal go West on 2nd Street Road to Hugoton Jct. go 2 mi on West 1 1/2 mi South and East into location	
2 WATER WELL OWNER: Gerald Elliott Mobil Oil Corp.	
RR#, St. Address, Box # : 609 Trimble Board of Agriculture, Division of Water Resources	
City, State, ZIP Code : Hugoton, Kansas 67951 Application Number: T 86-382	
3 LOCATE WELL'S LOCATION WITH AN "X" IN SECTION BOX:		4 DEPTH OF COMPLETED WELL... 320... ft. ELEVATION:	
		Depth(s) Groundwater Encountered 1... 175... ft. 2... ft. 3... ft.	
		WELL'S STATIC WATER LEVEL .. 145... ft. below land surface measured on mo/day/yr 11/29/86	
		Pump test data: Well water was ... ft. after ... hours pumping ... gpm	
		Est. Yield ... gpm: Well water was ... ft. after ... hours pumping ... gpm	
		Bore Hole Diameter... 11... in. to ... 320... ft., and ... in. to ... ft.	
		WELL WATER TO BE USED AS: 5 Public water supply 8 Air conditioning 11 Injection well	
		1 Domestic 3 Feedlot 6 Oil field water supply 9 Dewatering 12 Other (Specify below)	
		2 Irrigation 4 Industrial 7 Lawn and garden only 10 Observation well	
		Was a chemical/bacteriological sample submitted to Department? Yes.....No.....; If yes, mo/day/yr sample was submitted	
		Water Well Disinfected? Yes No	
5 TYPE OF BLANK CASING USED:	
1 Steel 3 RMP (SR) 5 Wrought iron 8 Concrete tile CASING JOINTS: Glued ... Clamped ...	
2 PVC 4 ABS 6 Asbestos-Cement 9 Other (specify below) Welded ...	
7 Fiberglass Threaded ...	
Blank casing diameter ... in. to ... ft., Dia ... in. to ... ft., Dia ... in. to ... ft.	
Casing height above land surface ... in., weight ... lbs./ft. Wall thickness or gauge No. ...	
TYPE OF SCREEN OR PERFORATION MATERIAL:	
1 Steel 3 Stainless steel 5 Fiberglass 7 PVC 10 Asbestos-cement	
2 Brass 4 Galvanized steel 6 Concrete tile 8 RMP (SR) 11 Other (specify) ...	
12 None used (open hole)	
SCREEN OR PERFORATION OPENINGS ARE:	
1 Continuous slot 3 Mill slot 5 Gauzed wrapped 8 Saw cut 11 None (open hole)	
2 Louvered shutter 4 Key punched 6 Wire wrapped 9 Drilled holes	
7 Torch cut 10 Other (specify) ...	
SCREEN-PERFORATED INTERVALS: From ... ft. to ... ft., From ... ft. to ... ft.	
From ... ft. to ... ft., From ... ft. to ... ft.	
GRAVEL PACK INTERVALS: From ... ft. to ... ft., From ... ft. to ... ft.	
From ... ft. to ... ft., From ... ft. to ... ft.	
6 GROUT MATERIAL: 1 Neat cement 2 Cement grout 3 Bentonite 4 Other ...	
Grout intervals: From ... ft. to ... ft., From ... ft. to ... ft., From ... ft. to ... ft.	
What is the nearest source of possible contamination:	
1 Septic tank 4 Lateral lines 7 Pit privy 10 Livestock pens 14 Abandoned water well	
2 Sewer lines 5 Cess pool 8 Sewage lagoon 11 Fuel storage 15 Oil well/Gas well	
3 Watertight sewer lines 6 Seepage pit 9 Feedyard 12 Fertilizer storage 16 Other (specify below)	
13 Insecticide storage	
Direction from well? How many feet?	
<table><tr><td>FROM</td><td>TO</td><td>LITHOLOGIC LOG</td><td>FROM</td><td>TO</td><td>LITHOLOGIC LOG</td></tr><tr><td></td><td></td><td>Log for plugging water well</td><td></td><td></td><td></td></tr><tr><td>0</td><td>4</td><td>dirt .79 cu. feet of dirt</td><td></td><td></td><td></td></tr><tr><td>4</td><td>14</td><td>cement 1.96 cu. feet of cement</td><td></td><td></td><td></td></tr><tr><td>14</td><td>135</td><td>sand 23.75 cu. feet of sand</td><td></td><td></td><td></td></tr><tr><td>135</td><td>145</td><td>cement 1.96 cu. feet of cement</td><td></td><td></td><td></td></tr><tr><td>145</td><td>320</td><td>sand 34.35 cu. feet of sand</td><td></td><td></td><td></td></tr>
7 CONTRACTOR'S OR LANDOWNER'S CERTIFICATION: This water well was (1) constructed, (2) reconstructed, or (3) plugged under my jurisdiction and was completed on (mo/day/year) February 3, 1987 and this record is true to the best of my knowledge and belief. Kansas Water Well Contractor's License No. 118 This Water Well Record was completed on (mo/day/yr) February 3, 1987 under the business name of Carlile Water Well Service, Inc. by (signature)	
INSTRUCTIONS: Use typewriter or ball point pen. PLEASE PRESS FIRMLY and PRINT clearly. Please fill in blanks, underline or circle the correct answers. Send top three copies to Kansas Department of Health and Environment, Bureau of Water Protection, Topeka, Kansas 66620-7320, Telephone: 913-862-9360. Send one to WATER WELL OWNER and retain one for your records.	