


1 LOCATION OF WATER WELL: Fraction SW 1/4 NE 1/4 NE 1/4 Section Number 7 Township Number T 35 S Range Number R 37 EW
 County: Stevens
 Distance and direction from nearest town or city street address of well if located within city? from Liberal, KS 22 Mi. West, 1 1/2 Mi. South, 1/2 Mi. West into location.

2 WATER WELL OWNER: Gerald Elliott
 RR#, St. Address, Box #: 609 Trimble
 City, State, ZIP Code: Hugoton, KS 67950
 Mobil Oil Corp.
 Board of Agriculture, Division of Water Resources
 Application Number: T89-291

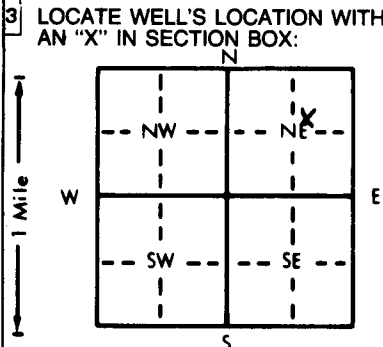

4 DEPTH OF COMPLETED WELL: 340 ft. ELEVATION:
 Depth(s) Groundwater Encountered 1. 155 ft. 2. 340 ft. 3. ft.
 WELL'S STATIC WATER LEVEL: 155 ft. below land surface measured on mo/day/yr 6-30-89
 Pump test data: Well water was ft. after hours pumping gpm
 Est. Yield: 100+ gpm; Well water was ft. after hours pumping gpm
 Bore Hole Diameter: 9-7/8" in. to 340 ft., and in. to ft.
 WELL WATER TO BE USED AS:
 1 Domestic 3 Feedlot 6 Oil field water supply 9 Dewatering 12 Other (Specify below)
 2 Irrigation 4 Industrial 7 Lawn and garden only 10 Monitoring well
 5 Public water supply 8 Air conditioning 11 Injection well
 Was a chemical/bacteriological sample submitted to Department? Yes No X; If yes, mo/day/yr sample was submitted
 Water Well Disinfected? Yes X No

5 TYPE OF BLANK CASING USED:
 1 Steel 3 RMP (SR) 5 Wrought iron 8 Concrete tile CASING JOINTS: Glued Clamped
 2 PVC 4 ABS 6 Asbestos-Cement 9 Other (specify below) Welded
 7 Fiberglass Threaded
 Blank casing diameter: 5.563 in. to 180 ft., Dia. in. to ft., Dia. in. to ft.
 Casing height above land surface: 60 in., weight 2.93 lbs./ft. Wall thickness or gauge No. 265
 TYPE OF SCREEN OR PERFORATION MATERIAL:
 1 Steel 3 Stainless steel 5 Fiberglass 8 RMP (SR) 10 Asbestos-cement 11 Other (specify)
 2 Brass 4 Galvanized steel 6 Concrete tile 9 ABS 12 None used (open hole)
 SCREEN OR PERFORATION OPENINGS ARE:
 1 Continuous slot 3 Mill slot 5 Gauzed wrapped 8 Saw cut 11 None (open hole)
 2 Louvered shutter 4 Key punched 6 Wire wrapped 9 Drilled holes
 7 Torch cut 10 Other (specify)
 SCREEN-PERFORATED INTERVALS: From 180 ft. to 340 ft., From ft. to ft.
 GRAVEL PACK INTERVALS: From 23 ft. to 155 ft., From 165 ft. to 340 ft.

6 GROUT MATERIAL: 1 Neat cement 2 Cement grout 3 Bentonite 4 Other
 Grout Intervals: From 5 ft. to 7 ft., From 7 ft. to 23 ft., From 155 ft. to 165 ft.
 What is the nearest source of possible contamination:
 1 Septic tank 4 Lateral lines 7 Pit privy 10 Livestock pens 14 Abandoned water well
 2 Sewer lines 5 Cess pool 8 Sewage lagoon 11 Fuel storage 15 Oil well/Gas well
 3 Watertight sewer lines 6 Seepage pit 9 Feedyard 12 Fertilizer storage 16 Other (specify below)
 13 Insecticide storage
 Direction from well? Southwest How many feet? 170'

FROM	TO	LITHOLOGIC LOG	FROM	TO	PLUGGING INTERVALS
			0	5	Backfill
			5	7	Neat Cement
			7	23	Bentonite Grout
			23	155	Chlorinated Gravel
			155	165	Bentonite Grout
			165	340	Chlorinated Gravel
					PVC CAP GLUED ON TOP OF CASING @ 5' BELOW GROUND SURFACE, CEMENTED OVER, THEN BACKFILLED.

7 CONTRACTOR'S OR LANDOWNER'S CERTIFICATION: This water well was (1) constructed, (2) reconstructed, or (3) plugged under my jurisdiction and was completed on (mo/day/year) 7-20-89 and this record is true to the best of my knowledge and belief. Kansas Water Well Contractor's License No. 118. This Water Well Record was completed on (mo/day/yr) 8-3-89 under the business name of Carlile Water Well Service, Inc. by (signature)