WATER WELL RECORD Form WWC-5 KSA 82a-1212

1 LOCATION OF WATER WELL: County: Stevens | Fraction: NW ¼ NW ¼ SW ¼ | Section Number: 8 | Township Number: T 35 S | Range Number: R 37 E/W

Distance and direction from nearest town or city street address of well if located within city?
From SW Corner of Hugoton - 11 Miles South, 5,230 Ft. West & 2,605 Ft. North

2 WATER WELL OWNER: Danny Price
RR#, St. Address, Box # : 905 Jackson St.
City, State, ZIP Code : Hugoton, Kansas 67951
Board of Agriculture, Division of Water Resources
Application Number: 41,000

3 LOCATE WELL'S LOCATION WITH AN "X" IN SECTION BOX:

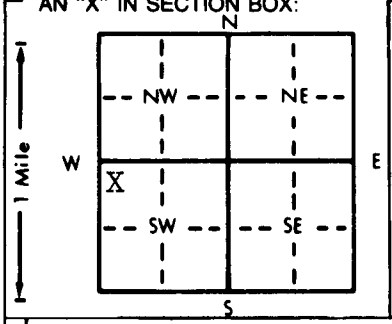

4 DEPTH OF COMPLETED WELL 490 ft. ELEVATION:
Depth(s) Groundwater Encountered 1. ft. 2. ft. 3. ft.
WELL'S STATIC WATER LEVEL 158 ft. below land surface measured on mo/day/yr 4-28-94
Pump test data: Well water was ft. after hours pumping gpm
Est. Yield gpm: Well water was ft. after hours pumping gpm
Bore Hole Diameter 30 in. to 490 ft., and in. to ft.
WELL WATER TO BE USED AS: 5 Public water supply 8 Air conditioning 11 Injection well
1 Domestic 3 Feedlot 6 Oil field water supply 9 Dewatering 12 Other (Specify below)
(2) Irrigation 4 Industrial 7 Lawn and garden only 10 Monitoring well
Was a chemical/bacteriological sample submitted to Department? Yes No X; If yes, mo/day/yr sample was submitted Water Well Disinfected? Yes No X

5 TYPE OF BLANK CASING USED: 5 Wrought iron 8 Concrete tile CASING JOINTS: Glued Clamped
(1) Steel 3 RMP (SR) 6 Asbestos-Cement 9 Other (specify below) Welded X
2 PVC 4 ABS 7 Fiberglass Threaded
Blank casing diameter 16 in. to 280 ft., Dia in. to ft., Dia in. to ft.
Casing height above land surface 12 in., weight 42.05 lbs./ft. Wall thickness or gauge No. 250

TYPE OF SCREEN OR PERFORATION MATERIAL: 7 PVC 10 Asbestos-cement
(1) Steel 3 Stainless steel 5 Fiberglass 8 RMP (SR) 11 Other (specify)
2 Brass 4 Galvanized steel 6 Concrete tile 9 ABS 12 None used (open hole)

SCREEN OR PERFORATION OPENINGS ARE: 5 Gauzed wrapped 8 Saw cut 11 None (open hole)
1 Continuous slot (3) Mill slot (6) Wire wrapped 9 Drilled holes
2 Louvered shutter 4 Key punched 7 Torch cut 10 Other (specify)

SCREEN-PERFORATED INTERVALS: From 280 ft. to 490 ft., From ft. to ft.
From ft. to ft., From ft. to ft.
GRAVEL PACK INTERVALS: From 30 ft. to 490 ft., From ft. to ft.
From ft. to ft., From ft. to ft.

6 GROUT MATERIAL: 1 Neat cement (2) Cement grout 3 Bentonite 4 Other
Grout Intervals: From 0 ft. to 30 ft., From ft. to ft., From ft. to ft.
What is the nearest source of possible contamination:
1 Septic tank 4 Lateral lines 7 Pit privy 10 Livestock pens 14 Abandoned water well
2 Sewer lines 5 Cess pool 8 Sewage lagoon 11 Fuel storage 15 Oil well/Gas well
3 Watertight sewer lines 6 Seepage pit 9 Feedyard 12 Fertilizer storage 16 Other (specify below)
13 Insecticide storage
Direction from well? How many feet? N/A

FROM	TO	LITHOLOGIC LOG	FROM	TO	PLUGGING INTERVALS
		See attached log			

7 CONTRACTOR'S OR LANDOWNER'S CERTIFICATION: This water well was (1) constructed, (2) reconstructed, or (3) plugged under my jurisdiction and was completed on (mo/day/year) 5-6-94 and this record is true to the best of my knowledge and belief. Kansas Water Well Contractor's License No. 208 This Water Well Record was completed on (mo/day/yr) 5-17-94
under the business name of Minter-Wilson Drilling Co., Inc. by (signature) Nora Keller

INSTRUCTIONS: Use typewriter or ball point pen. *PLEASE PRESS FIRMLY* and *PRINT* clearly. Please fill in blanks, underline or circle the correct answers. Send top three copies to Kansas Department of Health and Environment, Bureau of Water, Topeka, Kansas 66620-0001. Telephone: 913-296-5545. Send one to WATER WELL OWNER and retain one for your records.

OFFICE USE ONLY T H E/W SEC. ¼ ¼ ¼

The Professionals **MINTER-WILSON DRILLING CO.** INCORPORATED

Irrigation and Domestic Water Systems Complete Installation and Repairing

Phone 276-8269 • P.O. Box A • GARDEN CITY, KANSAS 67846

Danny Price
Stevens County
3-4-93

Location: W½ 8-35-37 - From West Side of Hugoton - 10 Miles South, 1 Mile West, ½ Mile South & 35 Ft. East

Static Water Level -

Test #1

0'	to	25'	- Top soil fine sand
25'	to	44'	- Brown clay
44'	to	62'	- Brown clay white rock mixed - tight
62'	to	102'	- Brown sandy clay
102'	to	115'	- Fine to medium sand
115'	to	149'	- Brown sandy clay white rock mixed
149'	to	155'	- Fine to medium sand
155'	to	172'	- Brown sandy clay white rock mixed
172'	to	216'	- Fine to medium sand - 15% clay
216'	to	385'	- Fine to medium sand gravel - loose
385'	to	400'	- Gray yellow clay mixed
400'	to	404'	- Fine to medium sand gravel - loose
404'	to		- Hard spot - pull down
404'	to	410'	- Fine to medium sand gravel - loose
410'	to	427'	- Gray yellow clay
427'	to	442'	- Gray yellow clay - small strip of sand stone
442'	to	456'	- Fine to medium sand - loose
456'	to	473'	- Yellow gray clay
473'	to	484'	- Fine to medium sand
484'	to	505'	- Gray yellow clay - small strip of sand
505'	to	577'	- Gray yellow clay - 25% fine sand
577'	to	599'	- Gray yellow clay
599'	to	635'	- Gray yellow clay - 35% fine sand