WATER WELL RECORD Form WWC-5 KSA 82a-1212

1 LOCATION OF WATER WELL: Fraction: SW ¼ SW ¼ SW ¼ | Section Number: 5 | Township Number: T 35 S | Range Number: R 37 E/W

County: STEVENS

Distance and direction from nearest town or city street address of well if located within city?

2 WATER WELL OWNER: BEREDCO

RR#, St. Address, Box # : 401 E. DOUGLAS, STE 402

City, State, ZIP Code : WICHITA, KS 67202

ROY DURE #1

Board of Agriculture, Division of Water Resources Application Number: 940440

3 LOCATE WELL'S LOCATION WITH AN "X" IN SECTION BOX:

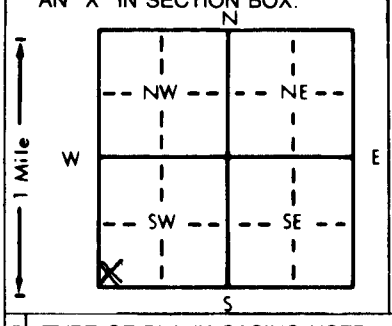

4 DEPTH OF COMPLETED WELL 400 ft. ELEVATION:

Depth(s) Groundwater Encountered 1. 150 ft. 2. ft. 3. ft.

WELL'S STATIC WATER LEVEL 150 ft. below land surface measured on mo/day/yr 10-21-94

Pump test data: Well water was 170 ft. after 1 hours pumping 95 gpm

Est. Yield 95 gpm: Well water was ft. after hours pumping gpm

Bore Hole Diameter 9½ in. to 400 ft., and in. to ft.

WELL WATER TO BE USED AS: 5 Public water supply 8 Air conditioning 11 Injection well; 1 Domestic 3 Feedlot (6) Oil field water supply 9 Dewatering 12 Other (Specify below); 2 Irrigation 4 Industrial 7 Lawn and garden only 10 Monitoring well

Was a chemical/bacteriological sample submitted to Department? Yes No X; If yes, mo/day/yr sample was submitted

Water Well Disinfected? Yes X No

5 TYPE OF BLANK CASING USED: 1 Steel 3 RMP (SR) 5 Wrought iron 8 Concrete tile; (2) PVC 4 ABS 6 Asbestos-Cement 9 Other (specify below) 7 Fiberglass

CASING JOINTS: Glued X Clamped; Welded; Threaded

Blank casing diameter 5 in. to 400 ft., Dia in. to ft., Dia in. to ft.

Casing height above land surface 24 in., weight 2.902 lbs./ft. Wall thickness or gauge No. .265 SDR 21

TYPE OF SCREEN OR PERFORATION MATERIAL: (7) PVC; 1 Steel 3 Stainless steel 5 Fiberglass 8 RMP (SR) 10 Asbestos-cement; 2 Brass 4 Galvanized steel 6 Concrete tile 9 ABS 11 Other (specify) 12 None used (open hole)

SCREEN OR PERFORATION OPENINGS ARE: 5 Gauzed wrapped (8) Saw cut 11 None (open hole); 1 Continuous slot 3 Mill slot 6 Wire wrapped 9 Drilled holes; 2 Louvered shutter 4 Key punched 7 Torch cut 10 Other (specify)

SCREEN-PERFORATED INTERVALS: From 340 ft. to 400 ft., From ft. to ft.

From ft. to ft., From ft. to ft.

GRAVEL PACK INTERVALS: From 320 ft. to 400 ft., From ft. to ft.

From ft. to ft., From ft. to ft.

6 GROUT MATERIAL: (1) Neat cement 2 Cement grout 3 Bentonite (4) Other HOLE PLUG

Grout Intervals: From 1 ft. to 20 ft., From ft. to ft., From ft. to ft.

What is the nearest source of possible contamination:

1 Septic tank 4 Lateral lines 7 Pit privy 10 Livestock pens 14 Abandoned water well

2 Sewer lines 5 Cess pool 8 Sewage lagoon 11 Fuel storage (15) Oil well/Gas well

3 Watertight sewer lines 6 Seepage pit 9 Feedyard 12 Fertilizer storage 16 Other (specify below)

13 Insecticide storage

Direction from well? How many feet?

FROM	TO	LITHOLOGIC LOG	FROM	TO	PLUGGING INTERVALS
0	2	SANDY CLAY	360	400	SAND & GRAVEL
2	16	CLAY			
16	86	CALICHE CLAY			
86	109	SANDY CLAY			
109	126	CALICHE CLAY			
126	176	SANDY CLAY			
176	186	FINE SAND			
186	190	CLAY			
190	206	SANDY CLAY			
206	218	COARSE SAND			
218	222	CLAY			
222	269	COARSE SAND			
269	273	CLAY			
273	284	SAND & SMALL GRAVEL			
284	360	COARSE SAND			

7 CONTRACTOR'S OR LANDOWNER'S CERTIFICATION: This water well was (1) constructed, (2) reconstructed, or (3) plugged under my jurisdiction and was completed on (mo/day/year) 10-21-94 and this record is true to the best of my knowledge and belief. Kansas Water Well Contractor's License No. KWWCL-430 This Water Well Record was completed on (mo/day/yr) 10-21-94 under the business name of HOWARD DRLG.CO.BOX 806 BEAVER, OK 73932 by (signature) Alvie Howard

INSTRUCTIONS: Use typewriter or ball point pen. *PLEASE PRESS FIRMLY* and *PRINT* clearly. Please fill in blanks, underline or circle the correct answers. Send top three copies to Kansas Department of Health and Environment, Bureau of Water, Topeka, Kansas 66620-0001. Telephone: 913-296-5545. Send one to WATER WELL OWNER and retain one for your records.

OFFICE USE ONLY T R E/W SEC. ¼ ¼ ¼