

USE TYPEWRITER OR BALL POINT PEN-PRESS FIRMLY, PRINT CLEARLY.


T R EW sec 1/4 1/4 1/4 No.

WATER WELL RECORD  
KSA 82a-1201-1215

Kansas State Dept. Of Health  
(Water Well Contractors)  
Forbes-Bldg. 740  
Topeka, Kansas 66620

1 Location of well:	County <b>Stevens</b>	Township name	Fraction <b>NW, SW, SE</b>	Section number <b>3</b>	Town number <b>35S</b>	Range number <b>38W</b>
---------------------	--------------------------	---------------	-------------------------------	----------------------------	---------------------------	----------------------------

Distance and direction from nearest town or city: <b>10 Miles S. &amp; 4 miles W. of Hugoton</b> Street address of well location if in city:	3 Owner of well: <b>Al Brecheisen</b> <b>R.R.</b> <b>Hugoton, Kansas</b> Address:
--	---

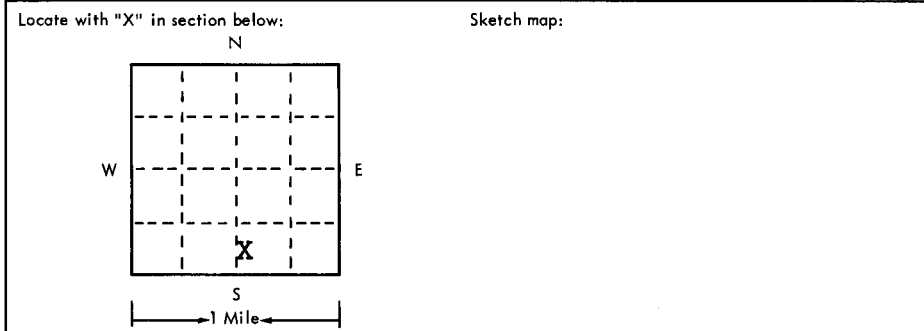

4 Well depth: 390 ft. Date of completion 3/31/75  
Well diameter 28 in.

5  Cable tool  Rotary  Driven  Dug  
 Hollow rod  Jetted  Bored  Reverse rotary

6 Use:  Domestic  Public supply  Industry  
 Irrigation  Air conditioning  Commercial  
 Test well

7 Casing: Material Stl Height: above/below  
Threaded  Welded  Surface I2 in.  
Diam. 37 lbs./ft. Weight 37  
16 n. to 390 ft. depth Drive shoe?  Yes  No  
   in. to    ft. depth!

2	Type and color of material	From	To
	<u>Well drilled near TH 3-74 (see attached), which is located 1155' North of S.W. corner of the SE<sup>1</sup>/<sub>4</sub>, Sec. 3, T35S, R38W, Stevens Co. Kansas</u>		
(use a second sheet if needed)			

8 Screen:  
Manufacturer Brown & Foster  
Type Louver & Millslot Dia. 16"  
Slot/gauze 1/8" Length 142'  
Set between 248 ft. and 390 ft.  
Fittings: 1-9MM  
Gravel pack  Yes  No Size range of material   

9 Static water level:  
157 ft. below land surface Date 1/31/75

10 Pumping level below land surfaces:  
179 ft. after 1/2 hrs. pumping 1640 g.p.m.  
193 ft. after 1 hrs. pumping 1910 g.p.m.  
Estimated maximum yield 2000 g.p.m.

11 Water sample submitted:  
 Yes  No Date   

12 Well head completion:  
 Pitless adapter  Inches above grade

13 Well grouted?  Yes  No  
 Neat cement  Bentonite      
Depth: From 0 ft. to 10 ft.

14 Nearest source of possible contamination: Unk  
ft.    Direction    Type     
Well disinfected upon completion?  Yes  No

15 Pump:  Not installed  
Manufacturer's name Layne  
Model number 14TL HP 160 Volts     
Length of drop pipe 240 ft. capacity 2000 g.p.m.  
Type:  
 Submersible  Turbine  
 Jet  Reciprocating  
 Centrifugal  Other

16 Remarks: elevation

Topography:  
 Hill  
 Slope  
 Upland  
 Valley

17 Water well contractor's certification:  
This well was drilled under my jurisdiction and this report is true to the best of my knowledge and belief.  
Layne-Western Company 150  
Business name Garden City, Ks. License No.     
Address     
Signed [Signature] Date     
Authorized representative    5-19-75

# TEST HOLE REPORT

## Layne-Western Company, Inc.



— WATER SUPPLY SERVICES SINCE 1924 —

TEST DRILLING • WATER WELLS • PUMPS

P.O. Box 686 - W. Hwy 50  
Garden City, Kansas 67846

Contract Name Al BrEcheisen

Job No. K-470

Date 12-11-74

City Hugoton

State Kansas

Driller McIntyre

TEST HOLE

No. 3-74

Location of Test Hole 1155' N of S.W. corner  
of \_\_\_\_\_

Elevation of Test Hole \_\_\_\_\_

1/4 SE 1/4 Sec. 3 of T 35S

R 38W, Stevens Co., Kansas

Static Water Level 150' Approx

Measured \_\_\_\_\_ Hours After Completion

From	To	Description of Strata	Water Bearing
0	2	Top soil	
2	102	Very fine sand clay lenses	
102	125	Tan clay	
125	137	Fine to coarse sand fine gravel	
137	245	Tan and pink clay sand lenses	
245	282	Fine to coarse sand clay lenses	
282	390	Fine to coarse sand fine to med. gravel	
390	400	Sandy pink clay	

Remarks: