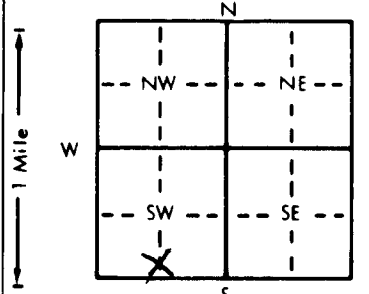


1 LOCATION OF WATER WELL: County: STEVENS	Fraction S2 1/4 S2 1/4 SW 1/4	Section Number 9	Township Number T 35 S	Range Number R 38W EW
--	----------------------------------	---------------------	---------------------------	--------------------------

Distance and direction from nearest town or city street address of well if located within city?

10 MILES SOUTH FETERITA

2 WATER WELL OWNER: BEREXCO INC. RR#, St. Address, Box # : 100 N BROADWAY STE. 970 City, State, ZIP Code : WICHITA, KS 67202-2209	#1-9 BRECHEISEN Board of Agriculture, Division of Water Resources Application Number: 940441
---	--

3 LOCATE WELL'S LOCATION WITH AN "X" IN SECTION BOX: 	4 DEPTH OF COMPLETED WELL: 320 ft. ELEVATION: Depth(s) Groundwater Encountered 1. 210 ft. 2. ft. 3. ft. WELL'S STATIC WATER LEVEL: 210 ft. below land surface measured on mo/day/yr 10-08-94 Pump test data: Well water was 230 ft. after 1 hours pumping 85 gpm Est. Yield 85 gpm Well water was ft. after hours pumping gpm Bore Hole Diameter 9 1/2 in. to 320 ft. and in. to ft. WELL WATER TO BE USED AS: 5 Public water supply 8 Air conditioning 11 Injection well 1 Domestic 3 Feedlot 6 Oil field water supply 9 Dewatering 12 Other (Specify below) 2 Irrigation 4 Industrial 7 Lawn and garden only 10 Monitoring well Was a chemical/bacteriological sample submitted to Department? Yes No X; If yes, mo/day/yr sample was submitted Water Well Disinfected? Yes X No
--	---

5 TYPE OF BLANK CASING USED: 1 Steel 3 RMP (SR) 5 Wrought iron 8 Concrete tile 2 PVC 4 ABS 6 Asbestos-Cement 9 Other (specify below) Blank casing diameter 5 in. to 320 ft. Dia in. to ft. Dia in. to ft. Casing height above land surface 24 in. weight 2.902 lbs./ft. Wall thickness or gauge No. 265 SDR 21 TYPE OF SCREEN OR PERFORATION MATERIAL: 1 Steel 3 Stainless steel 5 Fiberglass 8 RMP (SR) 10 Asbestos-cement 2 Brass 4 Galvanized steel 6 Concrete tile 9 ABS 11 Other (specify) 12 None used (open hole) SCREEN OR PERFORATION OPENINGS ARE: 1 Continuous slot 3 Mill slot 5 Gauzed wrapped 8 Saw cut 11 None (open hole) 2 Louvered shutter 4 Key punched 6 Wire wrapped 9 Drilled holes 7 Torch cut 10 Other (specify) SCREEN-PERFORATED INTERVALS: From 260 ft. to 320 ft. From ft. to ft. GRAVEL PACK INTERVALS: From 220 ft. to 320 ft. From ft. to ft. From ft. to ft. From ft. to ft.
---

6 GROUT MATERIAL: 1 Neat cement 2 Cement grout 3 Bentonite 4 Other HOLE PLUG Grout intervals: From 1 ft. to 20 ft. From ft. to ft. From ft. to ft. What is the nearest source of possible contamination: 1 Septic tank 4 Lateral lines 7 Pit privy 10 Livestock pens 14 Abandoned water well 2 Sewer lines 5 Cess pool 8 Sewage lagoon 11 Fuel storage 15 Oil well/Gas well 3 Watertight sewer lines 6 Seepage pit 9 Feedyard 12 Fertilizer storage 16 Other (specify below) 13 Insecticide storage Direction from well? Northwest How many feet? 300
--

FROM	TO	LITHOLOGIC LOG	FROM	TO	PLUGGING INTERVALS
0	4	SAND			
4	12	CLAY			
12	73	SANDY CLAY			
73	95	CLAY			
95	134	SANDY CLAY			
134	163	FINE SAND W/CLAY STREAKS			
163	186	CLAY W/FINE SAND STREAKS			
186	209	SAND & SMALL GRAVEL			
209	216	SANDY CLAY			
216	252	SAND & LARGE GRAVEL W/SANDY CLAY STREAKS			
252	269	SANDY CLAY W/FINE SAND			
269	316	SAND & GRAVEL			
316	320	BLUE & YELLOW CLAY			

7 CONTRACTOR'S OR LANDOWNER'S CERTIFICATION: This water well was (1) constructed, (2) reconstructed, or (3) plugged under my jurisdiction and was completed on (mo/day/year) 11-08-94 and this record is true to the best of my knowledge and belief. Kansas Water Well Contractor's License No. KWWCL-430 This Water Well Record was completed on (mo/day/year) 11-08-94 under the business name of HOWARD DRLG.CO.BOX 806 BEAVER, OK 73932 by (signature) Howard Drlg Co.
---

INSTRUCTIONS: Use typewriter or ball point pen. PLEASE PRESS FIRMLY and PRINT clearly. Please fill in blanks, underline or circle the correct answers. Send top three copies to Kansas Department of Health and Environment, Bureau of Water, Topeka, Kansas 66620-0001. Telephone: 913-296-5545. Send one to WATER WELL OWNER and retain one for your records.