

1 LOCATION OF WATER WELL:	Fraction	Section Number	Township Number	Range Number
County: STEVENS	SE 1/4 SE 1/4 NE 1/4	12	T 35 S	R 39 EW

Distance and direction from nearest town or city street address of well if located within city?

9 S. 1 W g. Jeterita, KS

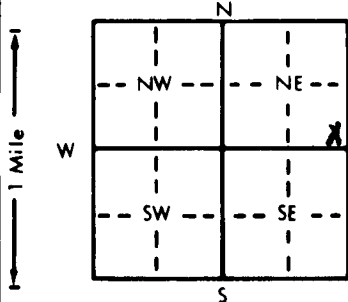
2 WATER WELL OWNER:	Board of Agriculture, Division of Water Resources
RR#, St. Address, Box # :	Application Number:
City, State, ZIP Code :	

Kramer ENTERPRISE

c/o JIM KRAMER

114 S. Monroe, Hugoton, KS 67951

3 LOCATE WELL'S LOCATION WITH AN "X" IN SECTION BOX:	4 DEPTH OF COMPLETED WELL: 485 ft. ELEVATION: Slope
--	---

Depth(s) Groundwater Encountered 1. **170** ft. 2. ft. 3. ft.WELL'S STATIC WATER LEVEL **170** ft. below land surface measured on mo/day/yr **2/8/96**

Pump test data: Well water was ft. after hours pumping gpm

Est. Yield gpm: Well water was ft. after hours pumping gpm

Bore Hole Diameter **6** in. to **485** ft., and in. to ft.

WELL WATER TO BE USED AS: 5 Public water supply 8 Air conditioning 11 Injection well

1 Domestic 3 Feedlot 6 Oil field water supply 9 Dewatering 12 Other (Specify below)

2 Irrigation 4 Industrial 7 Lawn and garden only 10 Monitoring well **Observation**Was a chemical/bacteriological sample submitted to Department? Yes No ☒ If yes, mo/day/yr sample was submittedWater Well Disinfected? Yes ☒ No

5 TYPE OF BLANK CASING USED:	5 Wrought iron	8 Concrete tile	CASING JOINTS: Glued ☒ Clamped ☒
1 Steel	3 RMP (SR)	6 Asbestos-Cement	9 Other (specify below)
2 PVC	4 ABS	7 Fiberglass	Welded
			Threaded

Blank casing diameter **2** in. to **445** ft. Dia in. to ft. Dia in. to ft.Casing height above land surface **2** in. weight **Schedule 40** lbs./ft. Wall thickness or gauge No.TYPE OF SCREEN OR PERFORATION MATERIAL: **PVC** 10 Asbestos-cement

1 Steel 3 Stainless steel 5 Fiberglass 8 RMP (SR) 11 Other (specify)

2 Brass 4 Galvanized steel 6 Concrete tile 9 ABS 12 None used (open hole)

SCREEN OR PERFORATION OPENINGS ARE: 5 Gauzed wrapped 8 Saw cut 11 None (open hole)

1 Continuous slot 3 Mill slot 6 Wire wrapped **9 Drilled holes**

2 Louvered shutter 4 Key punched 7 Torch cut 10 Other (specify)

SCREEN-PERFORATED INTERVALS: From **445** ft. to **485** ft. From ft. to ft.

From ft. to ft. From ft. to ft.

GRAVEL PACK INTERVALS: From **20** ft. to **485** ft. From ft. to ft.

From ft. to ft. From ft. to ft.

6 GROUT MATERIAL:	1 Neat cement	2 Cement grout	3 Bentonite	4 Other
-------------------	---------------	-----------------------	-------------	---------

Grout Intervals: From **0** ft. to **20** ft. From ft. to ft. From ft. to ft.

What is the nearest source of possible contamination: 10 Livestock pens 14 Abandoned water well

1 Septic tank 4 Lateral lines 7 Pit privy 11 Fuel storage 15 Oil well/Gas well

2 Sewer lines 5 Cess pool 8 Sewage lagoon 12 Fertilizer storage 16 Other (specify below)

3 Watertight sewer lines 6 Seepage pit 9 Feedyard 13 Insecticide storage **None**

Direction from well? How many feet?

FROM	TO	LITHOLOGIC LOG	FROM	TO	PLUGGING INTERVALS
0	2	Surface			
2	50	Fine sand			
50	70	Fine to medium sand			
70	185	Brown clay			
185	280	Brown clay w/ fine sand			
280	322	Fine to medium sand w/ clay breakers			
322	355	Medium to coarse sand w/ small clay breakers			
355	365	Red & brown clay			
365	385	Coarse sand			
385	400	Red & brown clay w/ sand strips			
400	445	" " " " w/ fine sand			
445	485	" " " " w/ medium to coarse sand			

7 CONTRACTOR'S OR LANDOWNER'S CERTIFICATION: This water well was (1) constructed , (2) reconstructed, or (3) plugged under my jurisdiction and was completed on (mo/day/year) 2-8-96 and this record is true to the best of my knowledge and belief, Kansas
Water Well Contractor's License No. 164 This Water Well Record was completed on (mo/day/yr) 3-12-96
under the business name of Houck Bros. Drilling Co. by (signature) M. Beard