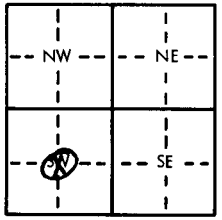
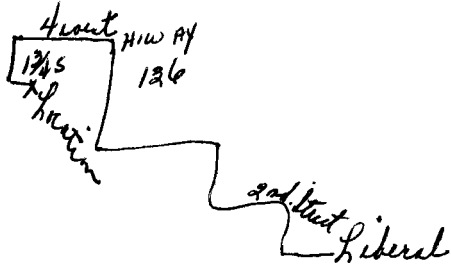


USE TYPEWRITER OR BALL
POINT PEN-PRESS FIRMLY,
PRINT CLEARLY.

WATER WELL RECORD
KSA 82a-1201-1215

Kansas Department of Health and
Environment-Division of Environment
(Water well Contractors)
Topeka, Kansas 66620

1. Location of well:	County Stevens	Fraction C SW 1/4 1/4 1/4	Section number 10	Township number 35 T S R	Range number 39 E/W
2. Distance and direction from nearest town or city: on 2nd street road to Hiway 136 4 west, 1 3/4 south, east to loc!			3. Owner of well: Zenith Drilling Co. R.R. or street: Suite 600, 200 West Douglas City, state, zip code: Wichita, Kansas 67202		
4. Locate with "X" in section below: N W E S 1 Mile 			Sketch map: 		
5. Type and color of material			From	To	6. Bore hole dia. <u>340</u> in. Completion date <u>3-8-77</u> Well depth <u>340</u> ft.
Surface			0	2	7. <input type="checkbox"/> Cable tool <input checked="" type="checkbox"/> Rotary <input type="checkbox"/> Driven <input type="checkbox"/> Dug <input type="checkbox"/> Hollow rod <input type="checkbox"/> Jetted <input type="checkbox"/> Bored <input type="checkbox"/> Reverse rotary
clay, fine sand			2	90	8. Use: <input type="checkbox"/> Domestic <input type="checkbox"/> Public supply <input type="checkbox"/> Industry <input type="checkbox"/> Irrigation <input type="checkbox"/> Air conditioning <input type="checkbox"/> Stock <input type="checkbox"/> Lawn <input checked="" type="checkbox"/> Oil field water <input type="checkbox"/> Other
sandy clay			90	160	9. Casing: Material <input type="checkbox"/> Height: Above or below Threaded <input type="checkbox"/> Welded <input type="checkbox"/> Surface <u>28</u> in. RMP <input type="checkbox"/> PVC <input checked="" type="checkbox"/> Weight <u>2.78</u> lbs./ft. Dia. <u>5</u> in. to <u>245</u> ft. depth Wall Thickness: inches or Dia. <u>5</u> in. to <u>340</u> ft. depth gage No. <u>.265</u>
fine sand			160	240	10. Screen: Manufacturer's name <u>sawed perf.</u> Type <u>PVC</u> Dia. <u>5</u> Slot/gauze <u>90</u> Length <u>90</u> Set between <u>245</u> ft. and <u>335</u> ft. <u>ft.</u> and <u>ft.</u> Gravel pack? <u>yes</u> Size range of material <u>1/8 to 3/16</u>
clay, fine sand, med. to lar. sand			240	280	11. Static water level: <u>190</u> ft. below land surface Date <u>3-8-77</u> mo./day/yr.
clay, fine sand 30-70			280	300	12. Pumping level below land surfaces: <u>ft.</u> after <u>hrs.</u> pumping <u>g.p.m.</u> <u>ft.</u> after <u>hrs.</u> pumping <u>g.p.m.</u> Estimated maximum yield <u>40</u> g.p.m.
clay, med. to lar. sand 60-40			300	340	13. Water sample submitted: <u>mo./day/yr.</u> Yes <input checked="" type="checkbox"/> No <input type="checkbox"/> Date <u>3-8-77</u>
					14. Well head completion: <u>Pitless adapter</u> <u>28</u> inches above grade
					15. Well grouted? <u>yes</u> With: <u>X</u> Neat cement <input type="checkbox"/> Bentonite <input type="checkbox"/> Concrete <input type="checkbox"/> Depth: From <u>0</u> ft. to <u>10</u> ft.
					16. Nearest source of possible contamination: ft. <u>100</u> Direction <u>NE</u> Type <u>oilwell</u> Well disinfected upon completion? <input checked="" type="checkbox"/> Yes <input type="checkbox"/> No
					17. Pump: <input checked="" type="checkbox"/> Not installed Manufacturer's name <u>Carlile Water Well</u> Model number <u>118</u> HP <u>1</u> Volts <u>115</u> Length of drop pipe <u>ft.</u> capacity <u>g.p.m.</u> Type: <input type="checkbox"/> Submersible <input type="checkbox"/> Turbine <input type="checkbox"/> Jet <input type="checkbox"/> Reciprocating <input type="checkbox"/> Centrifugal <input type="checkbox"/> Other
(Use a second sheet if needed)					
18. Elevation:		19. Remarks:		20. Water well contractor's certification: This well was drilled under my jurisdiction and this report is true to the best of my knowledge and belief. Carlile Water Well 118 Business name <u>Box 275, Liberal, Kd.</u> License No. <u>3-18</u> Address <u>Edward E. Means</u> Date <u>3-18</u> Signed <u>1977</u> Authorized representative	
Topography: <input type="checkbox"/> Hill <input type="checkbox"/> Slope <input checked="" type="checkbox"/> Upland <input type="checkbox"/> Valley					