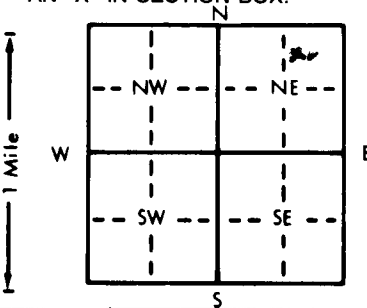


1 LOCATION OF WATER WELL:		Fraction		Section Number		Township Number		Range Number	
County: <b>Stevens</b>		<b>SW</b> ¼ <b>NE</b> ¼ <b>NE</b> ¼		<b>12</b>		<b>T 35</b> S		<b>R 39</b> <b>EW</b>	
Distance and direction from nearest town or city street address of well if located within city? <b>9 miles South of Feterita, KS</b>									
2 WATER WELL OWNER: <b>USA 0-1</b> <b>Gabbert &amp; Jones</b> RR#, St. Address, Box # : <b>333 E. English Suite 215</b> City, State, ZIP Code : <b>Wichita, KS 67202</b> Board of Agriculture, Division of Water Resources Application Number: <b>T89-301</b>									
3 LOCATE WELL'S LOCATION WITH AN "X" IN SECTION BOX:			4 DEPTH OF COMPLETED WELL: <b>420</b> ft. ELEVATION: <b>190</b> ft.						
			Depth(s) Groundwater Encountered 1. <b>230</b> ft. 2. <b>190</b> ft. 3. <b>190</b> ft.						
			WELL'S STATIC WATER LEVEL <b>230</b> ft. below land surface measured on mo/day/yr <b>7-12-89</b>						
			Pump test data: Well water was <b>200</b> ft. after <b>2</b> hours pumping <b>60</b> gpm						
			Est. Yield <b>65</b> gpm: Well water was <b>200</b> ft. after <b>2</b> hours pumping <b>60</b> gpm						
			Bore Hole Diameter <b>4</b> in. to <b>420</b> ft. and <b>420</b> in. to <b>420</b> ft.						
			WELL WATER TO BE USED AS: 1 Domestic 3 Feedlot <u>6 Oil field water supply</u> 9 Dewatering 12 Other (Specify below) 2 Irrigation 4 Industrial 7 Lawn and garden only 10 Monitoring well						
			Was a chemical/bacteriological sample submitted to Department? Yes <b>X</b> No <b>X</b> ; If yes, mo/day/yr sample was submitted <b>7-12-89</b>						
			Water Well Disinfected? Yes <b>X</b> No <b>X</b>						
5 TYPE OF BLANK CASING USED: 1 Steel 3 RMP (SR) 5 Wrought iron 8 Concrete tile CASING JOINTS: Glued <b>X</b> Clamped <b>X</b> <u>2 PVC</u> 4 ABS 6 Asbestos-Cement 9 Other (specify below) Welded <b>X</b> Blank casing diameter <b>5</b> in. to <b>320</b> ft. Dia <b>200</b> in. to <b>200</b> ft. Dia <b>0.265</b> lbs./ft. Wall thickness or gauge No. <b>0.265</b> Casing height above land surface <b>14</b> in. weight <b>200</b> lbs./ft.									
TYPE OF SCREEN OR PERFORATION MATERIAL: 1 Steel 3 Stainless steel 5 Fiberglass 7 PVC 10 Asbestos-cement 2 Brass 4 Galvanized steel 6 Concrete tile 8 RMP (SR) 11 Other (specify) <b>7 PVC</b> SCREEN OR PERFORATION OPENINGS ARE: 1 Continuous slot 3 Mill slot 5 Gauzed wrapped <u>8 Saw cut</u> 11 None (open hole) 2 Louvered shutter 4 Key punched 6 Wire wrapped 9 Drilled holes 7 Torch cut 10 Other (specify) <b>7 PVC</b>									
SCREEN-PERFORATED INTERVALS: From <b>320</b> ft. to <b>420</b> ft. From <b>420</b> ft. to <b>420</b> ft. From <b>420</b> ft. to <b>420</b> ft.									
GRAVEL PACK INTERVALS: From <b>220</b> ft. to <b>420</b> ft. From <b>420</b> ft. to <b>420</b> ft. From <b>420</b> ft. to <b>420</b> ft.									
6 GROUT MATERIAL: <u>1 Neat cement</u> 2 Cement grout 3 Bentonite 4 Other Grout Intervals: From <b>20</b> ft. to <b>0</b> ft. From <b>0</b> ft. to <b>0</b> ft. From <b>0</b> ft. to <b>0</b> ft. From <b>0</b> ft. to <b>0</b> ft.									
What is the nearest source of possible contamination: 1 Septic tank 4 Lateral lines 7 Pit privy 10 Livestock pens 14 Abandoned water well 2 Sewer lines 5 Cess pool 8 Sewage lagoon 11 Fuel storage <u>15 Oil well/Gas well</u> 3 Watertight sewer lines 6 Seepage pit 9 Feedyard 12 Fertilizer storage 16 Other (specify below) Direction from well? <b>Southwest</b> How many feet? <b>300</b>									
FROM TO LITHOLOGIC LOG FROM TO PLUGGING INTERVALS									
0 230 Overburden									
230 330 Clay & thin streaks of sand									
330 360 Medium sand									
360 373 Clay									
373 420 Medium sand and thin clay streaks									
7 CONTRACTOR'S OR LANDOWNER'S CERTIFICATION: This water well was <u>(1) constructed</u> , (2) reconstructed, or (3) plugged under my jurisdiction and was completed on (mo/day/year) <b>7-12-89</b> and this record is true to the best of my knowledge and belief. Kansas Water Well Contractor's License No. <b>142</b> This Water Well Record was completed on (mo/day/yr) <b>7-14-89</b> under the business name of <b>T &amp; W Water Well Service, Inc.</b> by (signature) <i>[Signature]</i>									