


WATER WELL RECORD Form WWC-5 KSA 82a-1212

1 LOCATION OF WATER WELL: Fraction NW 1/4 SE 1/4 SE 1/4 Section Number 7 Township Number T 35 S Range Number R 41 W
 COUNTY: MORTON

Distance and direction from nearest town or city street address of well if located within city?
 FROM ELKHART, KS. - 4 MILES EAST & 1 1/2 NORTH

2 WATER WELL OWNER: BARNES, ERNEST
 RRF, St. Address, Box #: BOX 933
 City, State, ZIP code: ELKHART, KS 67950- Board of Agriculture, Division of Water Resources
 Application Number:

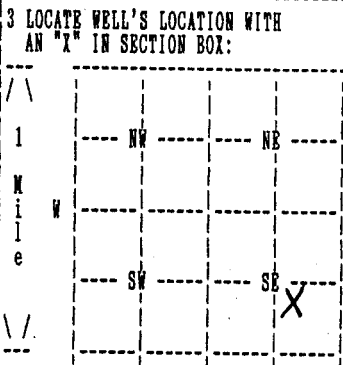

4 DEPTH OF COMPLETED WELL 320 ELEVATION: 0
 Depth(s) Groundwater Encountered 1. 0 ft. 2. 0 ft. 3. 0 ft.
 WELL'S STATIC WATER LEVEL 190 ft. below land surface measured on mo/day/yr 09/06/94
 Pump testdata: Well water was 0 ft. after 0 hours pumping 0 gpm
 Estimated Yield 20 gpm: Well water was 0 ft. after 0 hours pumping 0 gpm
 Bore Hole Diameter 9 in. to 320 ft., and in. to 0 ft.
 WELL WATER TO BE USED AS: DOMESTIC
 Was a chemical/bacteriological sample submitted to department? No ;
 If yes, mo/day/yr sample was submitted Water well disinfected? Yes

5 TYPE OF BLANK CASING USED: PVC CASING JOINTS: GLOUED
 Blank casing diameter 5 in. to 320 ft., Dia in. to 0 ft., Dia in. to 0 ft.
 Casing height above land surface 12 in., weight 200 lbs/ft. Wall thickness or gauge No. 21
 TYPE OF SCREEN OR PERFORATION MATERIAL: PVC
 SCREEN OR PERFORATION OPENINGS ARE: SAW CUT

SCREEN PERFORATED INTERVALS: From 200 ft. to 220 ft., From 0 ft. to 0 ft.
 From 300 ft. to 320 ft., From 0 ft. to 0 ft.
 GRAVEL PACK INTERVALS: From 25 ft. to 320 ft., From 0 ft. to 0 ft.
 From 0 ft. to 0 ft., From 0 ft. to 0 ft.

6 GROUT MATERIAL BENTONITE
 Grout Intervals: From 0 ft. to 25 ft., From 0 ft. to 0 ft., From 0 ft. to 0 ft.
 What is the nearest source of possible contamination: NONE - NEW SITE
 Direction from well? How many feet? 0

FROM	TO	LITHOLOGIC LOG	FROM	TO	PLUGGING INTERVALS
0	10	TOPSOIL SAND CLAY			
10	65	BROWN CLAY			
65	170	CALACHIE ROCK BROWN CLAY			
170	182	BROWN CLAY			
182	220	SAND MEDIUM SAND CLAY			
220	262	CLAY SAND			
262	320	FINE SAND CLAY			
320		Red Bed			

7 CONTRACTOR'S OR LANDOWNER'S CERTIFICATION: This water well was Constructed under my jurisdiction and was completed on (mo/day/year) 09/06/94 and this record is true to the best of my knowledge and belief. Kansas Water Well Contractor's License No. 179 This Water Well Record was completed on (mo/day/yr) 09/14/94 under the business name of JOB'S WELL SERVICE, INC. by (signature) *Justin Crist*