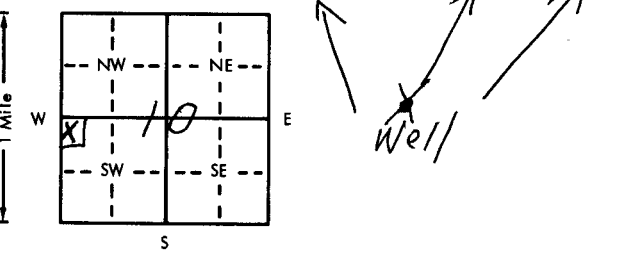


1. Location of well:		County <b>Morton</b>	Fraction <b>NW 1/4 NW 1/4 SW 1/4</b>	Section number <b>10</b>	Township number <b>T 35</b>	Range number <b>R 42</b>
2. Distance and direction from nearest town or city: <b>1 MI. N.E. ELKHART-KANS</b>				3. Owner of well: <b>DON DAVES</b>		
Street address of well location if in city:				City, state, zip code: <b>ELKHART KANS 67950</b>		
4. Locate with "X" in section below: 				6. Bore hole dia. <b>6 3/4</b> in. Completion date <b>4-26-</b> Well depth <b>300</b> ft.		
5. Type and color of material				7. <input checked="" type="checkbox"/> Cable tool <input checked="" type="checkbox"/> Rotary <input type="checkbox"/> Driven <input type="checkbox"/> Dug <input type="checkbox"/> Hollow rod <input type="checkbox"/> Jetted <input type="checkbox"/> Bored <input type="checkbox"/> Reverse rotary		
				8. Use: <input checked="" type="checkbox"/> Domestic <input type="checkbox"/> Public supply <input type="checkbox"/> Industry <input type="checkbox"/> Irrigation <input type="checkbox"/> Air conditioning <input type="checkbox"/> Stock <input type="checkbox"/> Lawn <input type="checkbox"/> Oil field water <input type="checkbox"/> Other		
				9. Casing: Material <input type="checkbox"/> Height: <input checked="" type="checkbox"/> Above or below Threaded <input type="checkbox"/> Welded <input type="checkbox"/> Surface <b>12</b> in. RMP <input type="checkbox"/> PVC <input checked="" type="checkbox"/> Weight <b>250</b> lbs./ft. Dia. <b>5</b> in. to <b>300</b> ft. depth Wall Thickness: inches or Dia. <input type="checkbox"/> in. to <input type="checkbox"/> ft. depth gage No. <b>250</b>		
				10. Screen: Manufacturer's name <input type="checkbox"/> Type <b>PVC</b> Dia. <b>5</b> Slot/gauze <b>1/8</b> Length <b>20'</b> Set between <b>250</b> ft. and <b>300</b> ft. Gravel pack? <input checked="" type="checkbox"/> Size range of material <b>1/4</b>		
Top Soil				11. Static water level: <input type="checkbox"/> mo./day/yr. <b>100</b> ft. below land surface Date <b>4-20-71</b>		
				12. Pumping level below land surfaces: <b>140</b> ft. after <b>2</b> hrs. pumping <b>40</b> g.p.m. <b>195</b> ft. after <b>24</b> hrs. pumping <b>40</b> g.p.m. Estimated maximum yield <b>40</b> g.p.m.		
CLAY BROWN SANDY				13. Water sample submitted: <input type="checkbox"/> mo./day/yr. <input type="checkbox"/> Yes <input checked="" type="checkbox"/> No Date <input type="checkbox"/>		
				14. Well head completion: <input type="checkbox"/> Pitless adapter <b>20</b> inches above grade		
SAND FINE				15. Well grouted? <b>No</b> With: <input type="checkbox"/> Neat cement <input type="checkbox"/> Bentonite <input checked="" type="checkbox"/> Concrete Depth: From <b>0</b> ft. to <b>10</b> ft.		
				16. Nearest source of possible contamination: <b>NONE</b> ft. <input type="checkbox"/> Direction <input type="checkbox"/> Type <input type="checkbox"/> Well disinfected upon completion? <input checked="" type="checkbox"/> Yes <input type="checkbox"/> No		
SAND CLAY STRINGERS				17. Pump: <input type="checkbox"/> Not installed <input checked="" type="checkbox"/> Manufacturer's name <b>TAIT CENTURY</b> Model number <b>30EC15</b> HP <b>3</b> Volts <b>115</b> Length of drop pipe <b>200</b> ft. capacity <b>40</b> g.p.m. Type: <input checked="" type="checkbox"/> Submersible <input type="checkbox"/> Turbine <input type="checkbox"/> Jet <input type="checkbox"/> Reciprocating <input type="checkbox"/> Centrifugal <input type="checkbox"/> Other		
				20. Water well contractor's certification: This well was drilled under my jurisdiction and this report is true to the best of my knowledge and belief. <b>Ralph H. Prigg, Drilling Contr</b> Business name <b>Springfield Co. 81073 154</b> License No. Address <b>Calder Woods</b> Signed <b>6-9-71</b> Date		
18. Elevation:				19. Remarks: <b>D. Daves</b>		
20. Water well contractor's certification: This well was drilled under my jurisdiction and this report is true to the best of my knowledge and belief. <b>Ralph H. Prigg, Drilling Contr</b> Business name <b>Springfield Co. 81073 154</b> License No. Address <b>Calder Woods</b> Signed <b>6-9-71</b> Date						