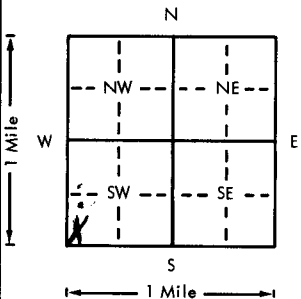


USE TYPEWRITER OR BALL
POINT PEN-PRESS FIRMLY,
PRINT CLEARLY.

WATER WELL RECORD
KSA 82a-1201-1215

Kansas Department of Health and
Environment-Division of Environment
(Water well Contractors)
Topeka, Kansas 66620

1. Location of well:		County <u>Morton</u>	Fraction <u>SW 1/4 SW 1/4 SW 1/4</u>	Section number <u>10</u>	Township number T <u>35</u> S	Range number R <u>42</u> E <u>W</u>
2. Distance and direction from nearest town or city: <u>APPROX 1/2 mile</u>		3. Owner of well: <u>B.W. Chain</u>				
Street address of well location if in city: <u>N.E. Elkhart</u>		R.R. or street: City, state, zip code: <u>Elkhart Ks</u>				
4. Locate with "X" in section below:		Sketch map:				
						
5. Type and color of material		From	To	6. Bore hole dia. <u>10</u> in. Completion date <u>9-28-78</u> Well depth <u>300</u> ft.		
<u>silty light gray soil</u>		<u>0</u>	<u>5</u>	7. ☒ Cable tool ☒ Rotary ☐ Driven ☐ Dug ☐ Hollow rod ☐ Jetted ☐ Bored ☐ Reverse rotary		
<u>" dark w/ some caliche nodules</u>		<u>5</u>	<u>10</u>	8. Use: ☒ Domestic ☐ Public supply ☐ Industry ☐ Irrigation ☐ Air conditioning ☐ Stock ☐ Lawn ☐ Oil field water ☐ Other		
<u>sand fine-brown w/ some silts</u>		<u>10</u>	<u>72</u>	9. Casing: Material ☐ Height: Above or below Threaded ☐ Welded ☐ Surface <u>24</u> in. RMP ☐ PVC <u>SC40</u> Weight <u>2-82</u> lbs./ft. Dia. <u>5</u> in. to <u>300</u> ft. depth Wall Thickness: inches or Dia. <u>5</u> in. to <u>300</u> ft. depth gage No. <u>1258</u>		
<u>caliche white w/ gravel + lime stone hard</u>		<u>72</u>	<u>92</u>	10. Screen: Manufacturer's name <u>Slocum</u> Type <u>saw cut</u> Dia. <u>5"</u> Slot/gauze <u>1/4</u> Length <u>40'</u> Set between <u>235</u> ft. and <u>255</u> ft. <u>275</u> ft. and <u>295</u> ft. Gravel pack? ☒ Size range of material <u>4 to 10</u>		
<u>" buff + white w/ some sand + gravel</u>		<u>102</u>	<u>220</u>	11. Static water level: <u>189</u> ft. below land surface Date <u>9-28-78</u> mo./day/yr.		
<u>lime rock stringers limy</u>				12. Pumping level below land surfaces: <u>197</u> ft. after <u>2</u> hrs. pumping <u>22</u> g.p.m. ft. after <u> </u> hrs. pumping <u> </u> g.p.m. Estimated maximum yield <u>60</u> g.p.m.		
<u>clay ball + sand w/ gravel</u>		<u>220</u>	<u>255</u>	13. Water sample submitted: <u> </u> mo./day/yr. Yes ☒ No ☐ Date <u> </u>		
<u>clay balls rusty brown silt + silt stone</u>		<u>255</u>	<u>273</u>	14. Well head completion: ☒ Pitless adapter <u>24"</u> inches above grade		
<u>silt s-tan sand + gravel + " "</u>		<u>273</u>	<u>275</u>	15. Well grouted? ☒ With: ☐ Neat cement ☐ Bentonite ☒ Concrete Depth: From <u>3</u> ft. to <u>13</u> ft.		
<u>(dakota) silts-rusty red w/ lime stone stringers</u>		<u>275</u>	<u>278</u>	16. Nearest source of possible contamination: ft. <u>150</u> Direction <u>NW</u> Type <u>septic</u> Well disinfected upon completion? ☒ Yes ☐ No		
<u>silts-tan w/ sand stone frag + " "</u>		<u>278</u>	<u>295</u>	17. Pump: Manufacturer's name <u>Beda</u> Not installed Model number <u>19018P</u> HP <u>2</u> Volts <u>230</u> Length of drop pipe <u>231</u> ft. capacity <u>23.5</u> g.p.m. Type: ☒ Submersible ☐ Turbine ☐ Jet ☐ Reciprocating ☐ Centrifugal ☐ Other		
<u>silts-rusty red</u>		<u>295</u>	<u>300</u>			
(Use a second sheet if needed)						
18. Elevation:		19. Remarks:		20. Water well contractor's certification: This well was drilled under my jurisdiction and this report is true to the best of my knowledge and belief. <u>Slocum Drilling</u> <u>127</u> Business name <u>HUGOTON, Ks</u> License No. <u> </u> Address <u>Paul Slocum</u> Signed <u>Paul Slocum</u> Date <u>12-22</u> Authorized representative		
Topography: ☐ Hill ☒ Slope ☐ Upland ☐ Valley						