

--

Send one white copy to Kansas Department of Health & Environment, Geology Section, 1000 SW Jackson Street, Ste. 420, Topeka, KS 66612-1367. Send one copy to WATER WELL OWNER and retain one for your records.
Visit us at <http://www.kdheks.gov/waterwell/index.html> Telephone 785-296-5524.

KSA82a-1212

Revised 1/29/2014

Border

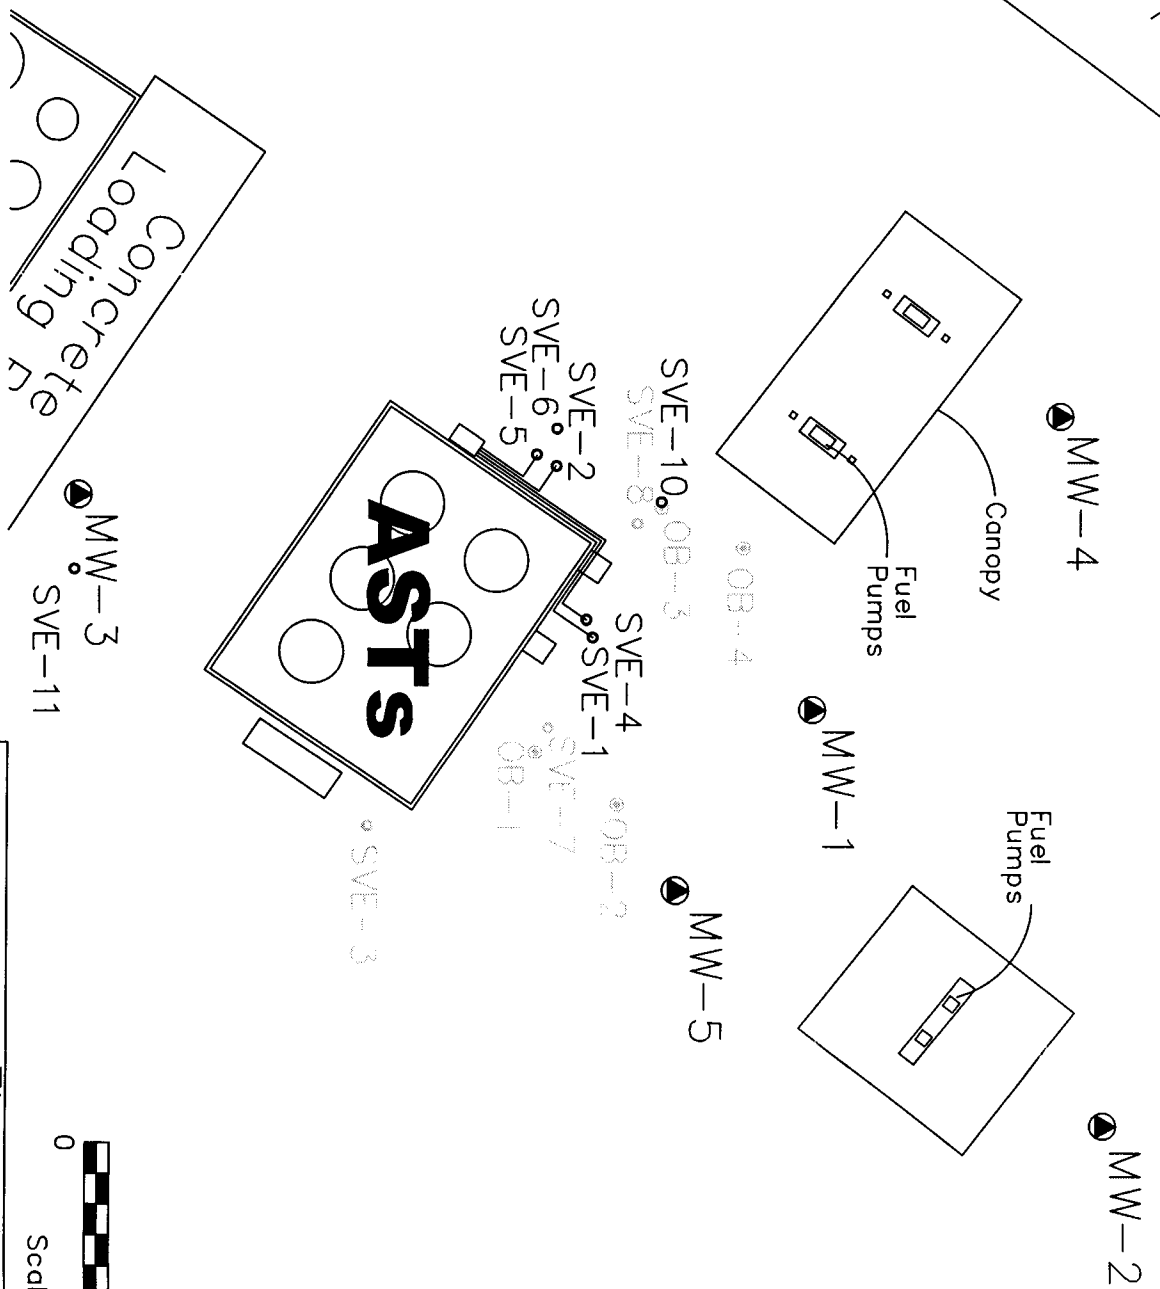


Figure 1
Site Base Map
Elkhardt Coop Ampride, Elkhardt

Bluestem Environmental Engineering, Inc.

Drawn By:	T. Pfau	Sample Date:		Date:	
Reviewed By:	Nick Hart, P.E.	KDHE Code:	A1-065-40261	File:	GW Figures.dwg
Scale:	1 inch = 30 feet				