

**Form WWC-5P**

**KSA 82a-1212**

ID NO.

\_\_\_\_\_

<b>1 LOCATION OF WATER WELL:</b> County: _____	Fraction <div style="display: flex; justify-content: space-around;"> <span>1/4</span> <span>1/4</span> <span>1/4</span> <span>1/4</span> </div>	Section Number _____	Township Number <div style="display: flex; justify-content: space-around;"> <span>T</span> <span>S</span> </div>	Range Number <div style="display: flex; justify-content: space-around;"> <span><input type="checkbox"/> E</span> <span><input type="checkbox"/> W</span> </div>	
Street/Rural Address of Well Location; if unknown, distance & direction from nearest town or intersection: If at owner's address, check here <input type="checkbox"/>		<b>Global Positioning Systems (GPS) information:</b> Latitude: _____ (in decimal degrees) Longitude: _____ (in decimal degrees) Elevation: _____ Datum: <input type="checkbox"/> WGS84, <input type="checkbox"/> NAD83, <input type="checkbox"/> NAD27 Collection Method: _____ <input type="checkbox"/> GPS unit (Make/Model: _____) <input type="checkbox"/> Digital Map/Photo, <input type="checkbox"/> Topographic Map, <input type="checkbox"/> Land Survey Est. Accuracy: <input type="checkbox"/> < 3 m, <input type="checkbox"/> 3-5 m, <input type="checkbox"/> 5-15 m, <input type="checkbox"/> > 15 m	
<b>2 WATER WELL OWNER:</b> RR#, St. Address, Box #: City, State ZIP Code:		<b>3 MARK WELL'S LOCATION WITH AN "X" IN SECTION BOX:</b> <div style="text-align: center;">             N  <table border="1" style="margin: auto; border-collapse: collapse;"> <tr> <td style="padding: 5px;">NW</td> <td style="padding: 5px;">NE</td> </tr> <tr> <td style="padding: 5px;">SW</td> <td style="padding: 5px;">SE</td> </tr> </table>             S  <div style="display: flex; justify-content: space-between; width: 100%;"> <span>W</span> <span>E</span> </div> </div>			NW	NE	SW	SE	
NW	NE	
SW	SE	
<b>4 DEPTH OF WELL</b> _____ ft. WELL'S STATIC WATER LEVEL _____ ft. WELL WAS USED AS: <div style="display: flex; justify-content: space-between;"> <div style="width: 30%;"> <input type="checkbox"/> Domestic  <input type="checkbox"/> Irrigation  <input type="checkbox"/> Feedlot  <input type="checkbox"/> Industrial         </div> <div style="width: 30%;"> <input type="checkbox"/> Public Water Supply  <input type="checkbox"/> Oil Field Water Supply  <input type="checkbox"/> Domestic (Lawn &amp; Garden)  <input type="checkbox"/> Air Conditioning         </div> <div style="width: 30%;"> <input type="checkbox"/> Dewatering  <input type="checkbox"/> Monitoring  <input type="checkbox"/> Injection Well  <input type="checkbox"/> Other _____         </div> </div> Was a chemical/bacteriological sample submitted to Department? Yes <input type="checkbox"/> No <input type="checkbox"/>	
<b>5 TYPE OF BLANK CASING USED:</b> <div style="display: flex; justify-content: space-between; margin-top: 10px;"> <div style="width: 15%;"> <input type="checkbox"/> Steel  <input type="checkbox"/> PVC         </div> <div style="width: 15%;"> <input type="checkbox"/> RMP (SR)  <input type="checkbox"/> ABS         </div> <div style="width: 15%;"> <input type="checkbox"/> Wrought  <input type="checkbox"/> Asbestos-Cement         </div> <div style="width: 15%;"> <input type="checkbox"/> Fiberglass  <input type="checkbox"/> Concrete Tile         </div> <div style="width: 30%;"> <input type="checkbox"/> Other (Specify below) _____         </div> </div> Blank casing diameter _____ in. Was casing pulled? Yes <input type="checkbox"/> No <input type="checkbox"/> If yes, how much _____ Casing height above or below land surface _____ in.	
<b>6 GROUT PLUG MATERIAL:</b> <input type="checkbox"/> Neat cement <input type="checkbox"/> Cement grout <input type="checkbox"/> Bentonite <input type="checkbox"/> Other _____ Grout Plug Intervals: From _____ ft. to _____ ft., From _____ ft. to _____ ft., From _____ ft. to _____ ft. What is the nearest source of possible contamination: <div style="display: flex; justify-content: space-between;"> <div style="width: 30%;"> <input type="checkbox"/> Septic tank  <input type="checkbox"/> Sewer lines  <input type="checkbox"/> Watertight sewer lines  <input type="checkbox"/> Lateral lines  <input type="checkbox"/> Cess pool         </div> <div style="width: 30%;"> <input type="checkbox"/> Seepage pit  <input type="checkbox"/> Pit privy  <input type="checkbox"/> Sewage lagoon  <input type="checkbox"/> Feedyard  <input type="checkbox"/> Livestock pens         </div> <div style="width: 30%;"> <input type="checkbox"/> Fuel storage  <input type="checkbox"/> Fertilizer storage  <input type="checkbox"/> Insecticide storage  <input type="checkbox"/> Abandoned water well  <input type="checkbox"/> Oil well/Gas well         </div> <div style="width: 30%;"> <input type="checkbox"/> Other (specify below) _____          Direction from well? _____          How many feet? _____         </div> </div>	
<table border="1" style="width: 100%; border-collapse: collapse;"> <thead> <tr> <th style="width: 10%;">FROM</th> <th style="width: 10%;">TO</th> <th style="width: 40%;">PLUGGING MATERIALS</th> <th style="width: 10%;">FROM</th> <th style="width: 10%;">TO</th> <th style="width: 40%;">PLUGGING MATERIALS</th> </tr> </thead> <tbody> <tr><td> </td><td> </td><td> </td><td> </td><td> </td><td> </td></tr> <tr><td> </td><td> </td><td> </td><td> </td><td> </td><td> </td></tr> <tr><td> </td><td> </td><td> </td><td> </td><td> </td><td> </td></tr> <tr><td> </td><td> </td><td> </td><td> </td><td> </td><td> </td></tr> <tr><td> </td><td> </td><td> </td><td> </td><td> </td><td> </td></tr> <tr><td> </td><td> </td><td> </td><td> </td><td> </td><td> </td></tr> <tr><td> </td><td> </td><td> </td><td> </td><td> </td><td> </td></tr> <tr><td> </td><td> </td><td> </td><td> </td><td> </td><td> </td></tr> </tbody> </table>					FROM	TO	PLUGGING MATERIALS	FROM	TO	PLUGGING MATERIALS	
FROM	TO	PLUGGING MATERIALS	FROM	TO	PLUGGING MATERIALS	
<b>7 CONTRACTOR'S OR LANDOWNER'S CERTIFICATION:</b> This water well was plugged under my jurisdiction and was completed on (mo/day/year) _____ and this record is true to the best of my knowledge and belief. Kansas Water Well Contractor's License No. _____. This Water Well Record was completed on (mo/day/year) _____ under the business name of _____ by (signature) _____	


Send one white copy to Kansas Department of Health & Environment, Geology Section, 1000 SW Jackson Street, Ste. 420, Topeka, KS 66612-1367. Send one copy to WATER WELL OWNER and retain one for your records.

Visit us at <http://www.kdheks.gov/waterwell/index.html> Telephone 785-296-5524.

KSA82a-1212

Revised 1/29/2014

Border

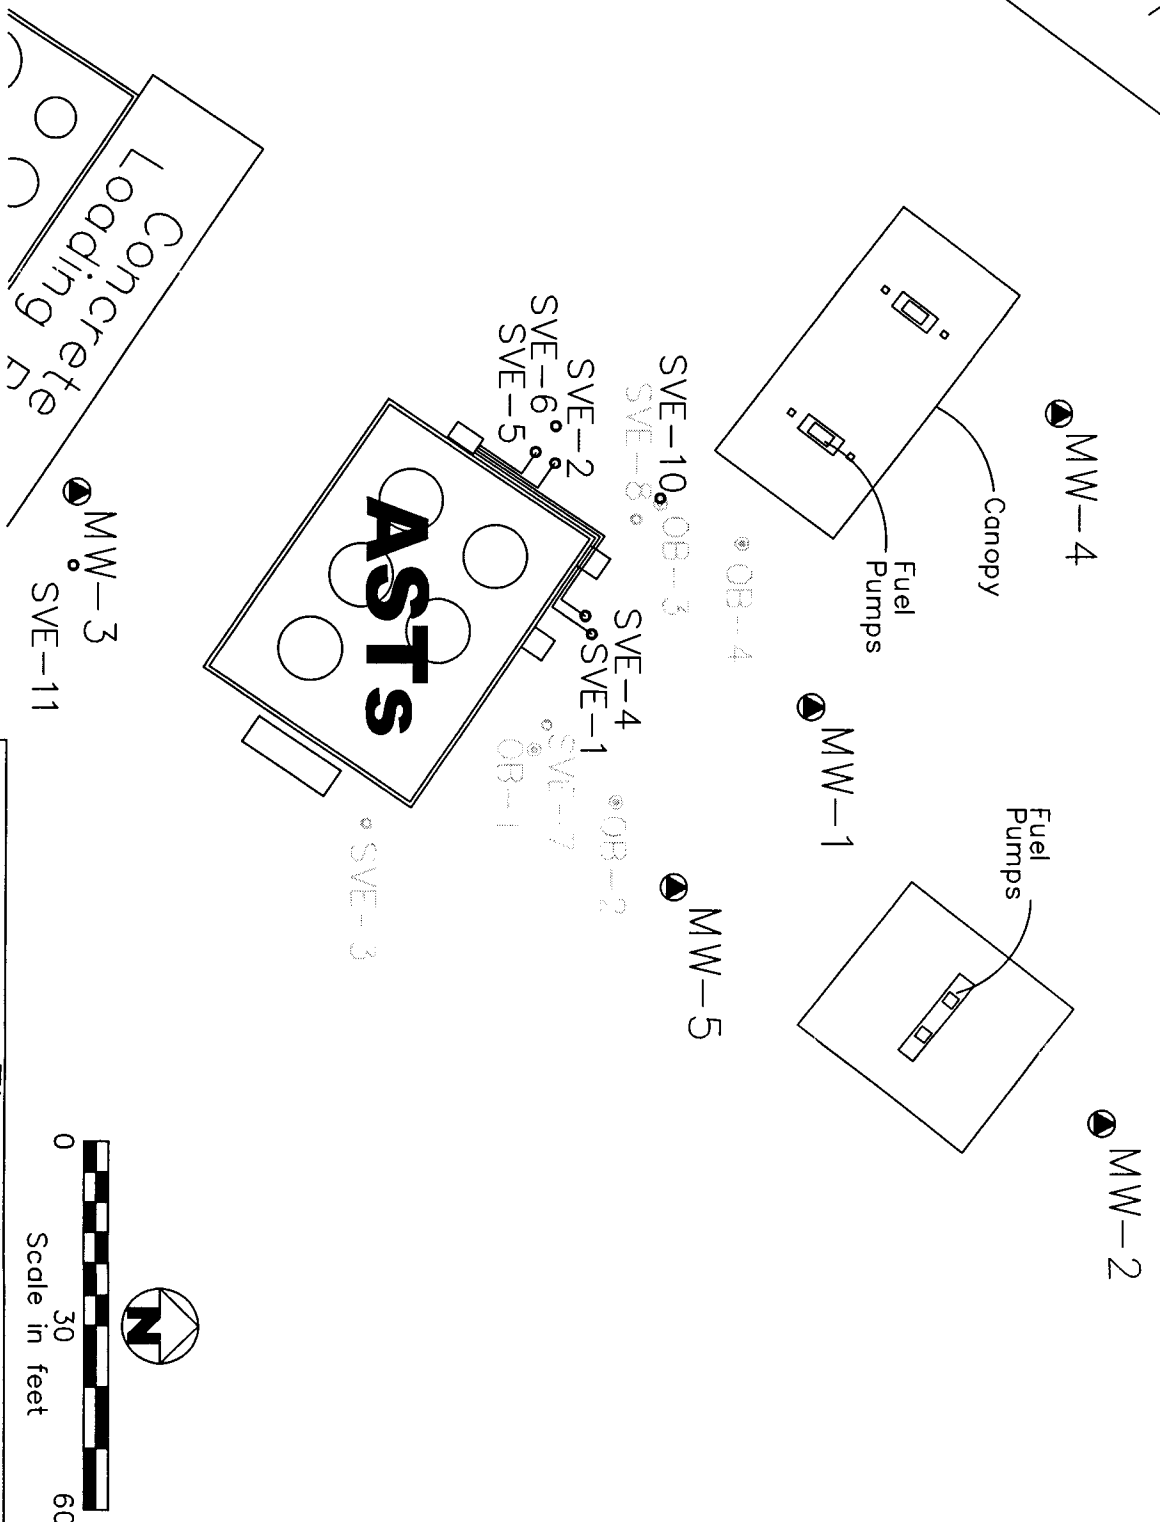

**Figure 1**  
**Site Base Map**  
**Elkhardt Coop Ampride, Elkhardt**

Bluestem Environmental Engineering, Inc.

Figure 1 Site Base Map Elkhart Coop Ampride, Elkhart			
Drawn By:	T. Pfau	Sample Date:	Date:
Reviewed By:	Nick Hart, P.E.	KDHE Code:	A1-065-40261
Scale:	1 inch = 30 feet	File:	GW Figures.dwg