

--

2 WATER WELL OWNER: RR#, St. Address, Box #: City, State ZIP Code:	<input type="checkbox"/> GPS unit (Make/Model: _____) <input type="checkbox"/> Digital Map/Photo, <input type="checkbox"/> Topographic Map, <input type="checkbox"/> Land Survey <u>Est. Accuracy:</u> <input type="checkbox"/> < 3 m, <input type="checkbox"/> 3-5 m, <input type="checkbox"/> 5-15 m, <input type="checkbox"/> > 15 m
---	---

5 TYPE OF BLANK CASING USED:

☐ Steel ☐ RMP (SR) ☐ Wrought ☐ Fiberglass ☐ Other (Specify below)
☐ PVC ☐ ABS ☐ Asbestos-Cement ☐ Concrete Tile _____

Blank casing diameter _____ in. Was casing pulled? Yes ☐ No ☐ If yes, how much _____

Casing height above or below land surface _____ in.

[illegible]

Send one white copy to Kansas Department of Health & Environment, Geology Section, 1000 SW Jackson Street, Ste. 420, Topeka, KS 66612-1367. Send one copy to WATER WELL OWNER and retain one for your records.
Visit us at <http://www.kdheks.gov/waterwell/index.html> Telephone 785-296-5524.

KSA82a-1212

Revised 1/29/2014

Border

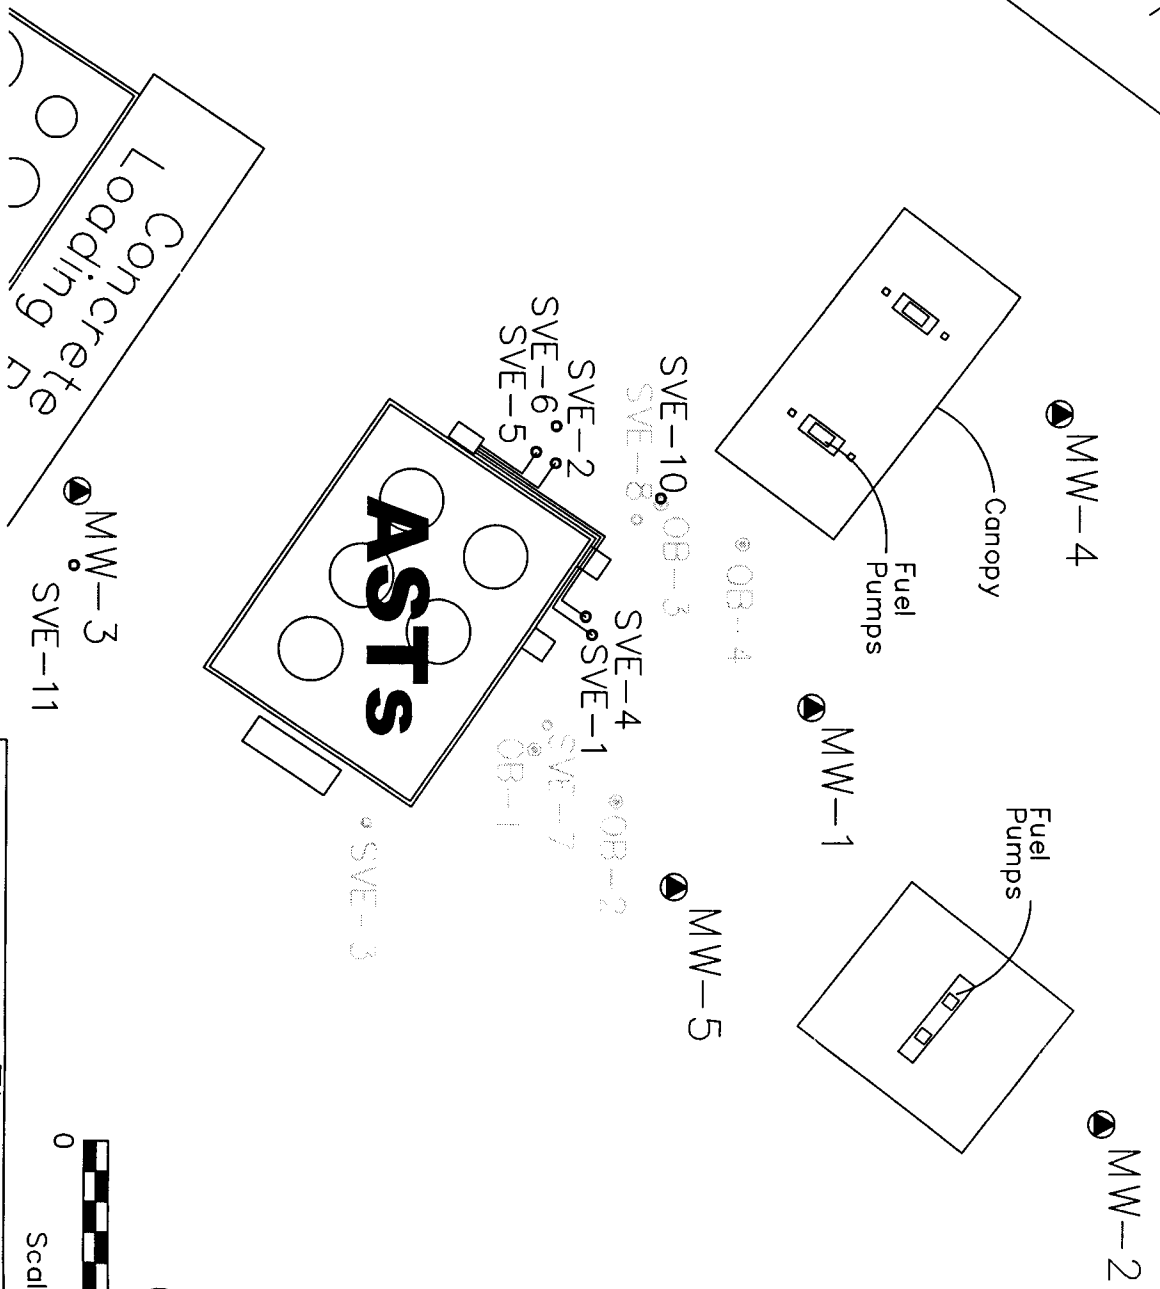


Figure 1
Site Base Map
 Elkhardt Coop Ampride, Elkhardt

Bluestem Environmental Engineering, Inc.

Figure 1 Site Base Map Elkhart Coop Ampride, Elkhart			
Drawn By: T. Pfau		Sample Date:	
Reviewed By: Nick Hart, P.E.		Date:	
KDIH Code: A1-065-40261			
Scale: 1 inch = 30 feet		File: GW Figures.dwg	