

WATER WELL RECORD Form WWC-5


Division of Water Resources App. No.

Well ID MW-1

Original Record Correction Change in Well Use

1 LOCATION OF WATER WELL: County: Morton Fraction NW 1/4 SW 1/4 NW 1/4 NW 1/4 Section Number 16 Township Number T 35 S Range Number R 42 E W

2 WELL OWNER: Last Name: Business: KDHE Address: 100 SW Jackson ST City: Topeka State: KS ZIP: 66612 Street or Rural Address where well is located: In Elkhart, KS

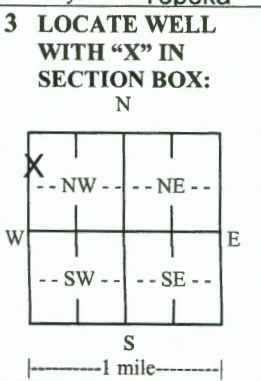

4 DEPTH OF COMPLETED WELL: 238 ft. Depth(s) Groundwater Encountered: 1) 210 ft. 2) ft. 3) ft. or 4) Dry Well WELL'S STATIC WATER LEVEL: 204.73 ft. below land surface, measured on (mo-day-yr) 07/15/2020

5 Latitude: 37.00855 (decimal degrees) Longitude: 101.898343 (decimal degrees) Datum: WGS 84 NAD 83 NAD 27 Source for Latitude/Longitude: GPS (unit make/model: ) (WAAS enabled? Yes No) Land Survey Topographic Map Online Mapper:

6 Elevation: 3609 ft. Ground Level TOC Source: Land Survey GPS Topographic Map Other KOLAR

7 WELL WATER TO BE USED AS: 1. Domestic: Household Lawn & Garden Livestock Irrigation Feedlot Industrial 2. Public Water Supply: well ID 3. Aquifer Recharge: well ID 4. Monitoring: well ID MW-1 5. Environmental Remediation: well ID 6. Air Sparge Soil Vapor Extraction Recovery Injection 7. Oil Field Water Supply: lease 8. Test Hole: well ID Cased Uncased Geotechnical 9. Geothermal: how many bores? a) Closed Loop Horizontal Vertical b) Open Loop Surface Discharge Inj. of Water 10. Other (specify):

Was a chemical/bacteriological sample submitted to KDHE? Yes No If yes, date sample was submitted: Water well disinfected? Yes No

8 TYPE OF CASING USED: Steel PVC Other CASING JOINTS: Glued Clamped Welded Threaded Casing diameter 4 in. to 238 ft., Diameter in. to ft., Diameter in. to ft. Casing height above land surface 0 in. Weight lbs./ft. Wall thickness or gauge No. SCH-80

TYPE OF SCREEN OR PERFORATION MATERIAL: Steel Stainless Steel PVC Other (Specify) Brass Galvanized Steel None used (open hole)

SCREEN OR PERFORATION OPENINGS ARE: Continuous Slot Mill Slot Gauze Wrapped Torch Cut Drilled Holes Other (Specify) Louvered Shutter Key Punched Wire Wrapped Saw Cut None (Open Hole)

SCREEN-PERFORATED INTERVALS: From 218 ft. to 238 ft., From ft. to ft., From ft. to ft. GRAVEL PACK INTERVALS: From 215 ft. to 238 ft., From ft. to ft., From ft. to ft.

9 GROUT MATERIAL: Neat cement Cement grout Bentonite Other Grout Intervals: From 0 ft. to 215 ft., From ft. to ft., From ft. to ft.

Nearest source of possible contamination: No potential source of contamination within 200 ft. Septic Tank Lateral Lines Pit Privy Livestock Pens Insecticide Storage Sewer Lines Cess Pool Sewage Lagoon Fuel Storage Abandoned Water Well Watertight Sewer Lines Seepage Pit Feedyard Fertilizer Storage Oil Well/Gas Well Other (Specify) Direction from well? Distance from well? ft.

Table with columns: FROM, TO, LITHOLOGIC LOG, FROM, TO, LITHO. LOG (cont.) or PLUGGING INTERVALS. Rows show depth intervals from 0 to 125 feet with descriptions of soil layers like 'Topsoil, dark brown, lean sandy clay with gravel' and 'Fine sand to coarse sand with light brown lean sand'.

11 CONTRACTOR'S OR LANDOWNER'S CERTIFICATION: This water well was constructed, reconstructed, or plugged under my jurisdiction and was completed on (mo-day-year) 07/15/2020 and this record is true to the best of my knowledge and belief. Kansas Water Well Contractor's License No. 914 This Water Well Record was completed on (mo-day-year) 08/18/2020 under the business name of Flint Hills Drilling #914





County Road B

RAMW-3

RAMW-2

RAMW-1

Commercial

RAMW-5

N Stevens Ave

N Stevens Ave

Residential

MW-4

N 1st St

Cosmos Ave

Residential

Residential

N 2nd St

Residential

MW-1

Commercial

MW-3

Residential

Residential

MW-2

N Stanton Ave

N Stanton Ave

Residential

Residential

Residential

Residential

MW-5

County Road B

1st St