WATER WELL RECORD Form WWC-5

☑ Original Record ☐ Correction ☐ Change in Well Use

Division of Water Resources App. No. [ ] Well ID MW-4

1 LOCATION OF WATER WELL: County: Morton | Fraction: NW ¼ SE ¼ NW ¼ NW ¼ | Section Number: 16 | Township Number: T 35 S | Range Number: R 42 ☐ E ☑ W

2 WELL OWNER: Last Name: First:
Business: KDHE
Address: 100 SW Jackson St
Address:
City: Topeka State: KS ZIP: 66612

Street or Rural Address where well is located (if unknown, distance and direction from nearest town or intersection) If at owner's address, check here: ☑
Corrected
In Elkhart, KS

3 LOCATE WELL WITH "X" IN SECTION BOX: N / W / E / S; X in NW; |----------1 mile---------|

4 DEPTH OF COMPLETED WELL: 238 ft.
Depth(s) Groundwater Encountered: 1) 210 ft. 2) ..... ft. 3) ..... ft., or 4) ☐ Dry Well
WELL'S STATIC WATER LEVEL: 205.91 ft.
☑ below land surface, measured on (mo-day-yr) 07/15/2020
☐ above land surface, measured on (mo-day-yr).....
Pump test data: Well water was ..... ft. after..... hours pumping ..... gpm
Well water was ..... ft. after..... hours pumping ..... gpm
Estimated Yield: .....gpm
Bore Hole Diameter: 8 in. to 238 ft. and ..... in. to ..... ft.

5 Latitude: 37.008346 (decimal degrees)
Longitude: 101.896025 (decimal degrees)
Datum: ☑ WGS 84 ☐ NAD 83 ☐ NAD 27
Source for Latitude/Longitude:
☐ GPS (unit make/model: .....) (WAAS enabled? ☐ Yes ☐ No)
☐ Land Survey ☐ Topographic Map
☐ Online Mapper: .....

6 Elevation: 3605 ft. ☑ Ground Level ☐ TOC
Source: ☐ Land Survey ☐ GPS ☐ Topographic Map ☑ Other KOLAR

7 WELL WATER TO BE USED AS:
1. Domestic: ☐ Household ☐ Lawn & Garden ☐ Livestock
2. ☐ Irrigation
3. ☐ Feedlot
4. ☐ Industrial
5. ☐ Public Water Supply: well ID .....
6. ☐ Dewatering: how many wells? .....
7. ☐ Aquifer Recharge: well ID .....
8. ☑ Monitoring: well ID MW-4
9. Environmental Remediation: well ID ..... ☐ Air Sparge ☐ Soil Vapor Extraction ☐ Recovery ☐ Injection
10. ☐ Oil Field Water Supply: lease .....
11. Test Hole: well ID ..... ☐ Cased ☐ Uncased ☐ Geotechnical
12. Geothermal: how many bores? ..... a) Closed Loop ☐ Horizontal ☐ Vertical b) Open Loop ☐ Surface Discharge ☐ Inj. of Water
13. ☐ Other (specify): .....

Was a chemical/bacteriological sample submitted to KDHE? ☐ Yes ☑ No If yes, date sample was submitted: .....
Water well disinfected? ☐ Yes ☑ No

8 TYPE OF CASING USED: ☐ Steel ☑ PVC ☐ Other ..... CASING JOINTS: ☐ Glued ☐ Clamped ☐ Welded ☑ Threaded
Casing diameter 4 in. to 238 ft., Diameter ..... in. to ..... ft., Diameter ..... in. to ..... ft.
Casing height above land surface 0 in. Weight ..... lbs./ft. Wall thickness or gauge No. SCH-80

TYPE OF SCREEN OR PERFORATION MATERIAL:
☐ Steel ☐ Stainless Steel ☑ PVC ☐ Other (Specify) .....
☐ Brass ☐ Galvanized Steel ☐ None used (open hole)

SCREEN OR PERFORATION OPENINGS ARE:
☐ Continuous Slot ☑ Mill Slot ☐ Gauze Wrapped ☐ Torch Cut ☐ Drilled Holes ☐ Other (Specify) .....
☐ Louvered Shutter ☐ Key Punched ☐ Wire Wrapped ☐ Saw Cut ☐ None (Open Hole)

SCREEN-PERFORATED INTERVALS: From 218 ft. to 238 ft., From ..... ft. to ..... ft., From ..... ft. to ..... ft.
GRAVEL PACK INTERVALS: From 215 ft. to 238 ft., From ..... ft. to ..... ft., From ..... ft. to ..... ft.

9 GROUT MATERIAL: ☐ Neat cement ☐ Cement grout ☑ Bentonite ☐ Other .....
Grout Intervals: From 0 ft. to 215 ft., From ..... ft. to ..... ft., From ..... ft. to ..... ft.

Nearest source of possible contamination: ✔ No potential source of contamination within 200 ft.
☐ Septic Tank ☐ Lateral Lines ☐ Pit Privy ☐ Livestock Pens ☐ Insecticide Storage
☐ Sewer Lines ☐ Cess Pool ☐ Sewage Lagoon ☐ Fuel Storage ☐ Abandoned Water Well
☐ Watertight Sewer Lines ☐ Seepage Pit ☐ Feedyard ☐ Fertilizer Storage ☐ Oil Well/Gas Well
☐ Other (Specify) .....
Direction from well? ..... Distance from well? ..... ft.

10 FROM	TO	LITHOLOGIC LOG	FROM	TO	LITHO. LOG (cont.) or PLUGGING INTERVALS
0	5	Surface soil and brown lean clay	145	160	Fine to coarse sand with light brown lean sa
5	70	Fine to coarse sand with light brown sand	160	195	Fine sand and dark red lean sandy clay
70	80	Fine to coarse sand	195	210	Fine to coarse sand
80	90	Fine to coarse sand and dark brown to ligl	210	240	Fine sand
90	95	Fine to coarse sand	240	245	Lean sandy red clay with fine sand
95	100	Light brown lean sandy clay with fine sanc			
100	115	Coarse sand with abundant caliche			
115	140	Fine to coarse sand with light brown lean :			
140	145	Fine sand			

Notes:

11 CONTRACTOR'S OR LANDOWNER'S CERTIFICATION: This water well was ☑ constructed, ☐ reconstructed, or ☐ plugged under my jurisdiction and was completed on (mo-day-year) 07/15/2020 and this record is true to the best of my knowledge and belief. Kansas Water Well Contractor's License No. 914 This Water Well Record was completed on (mo-day-year) 08/18/2020 under the business name of Flint Hills Drilling #914

Send one copy to WATER WELL OWNER and retain one for your records. Fee of $5.00 for each constructed well.
KS Department of Health and Environment, Bureau of Water, Geology Section, 1000 SW Jackson St., Suite 420, Topeka, Kansas 66612-1367. Telephone 785-296-3565.
Visit us at http://www.kdheks.gov/waterwell/index.html KSA 82a-1212

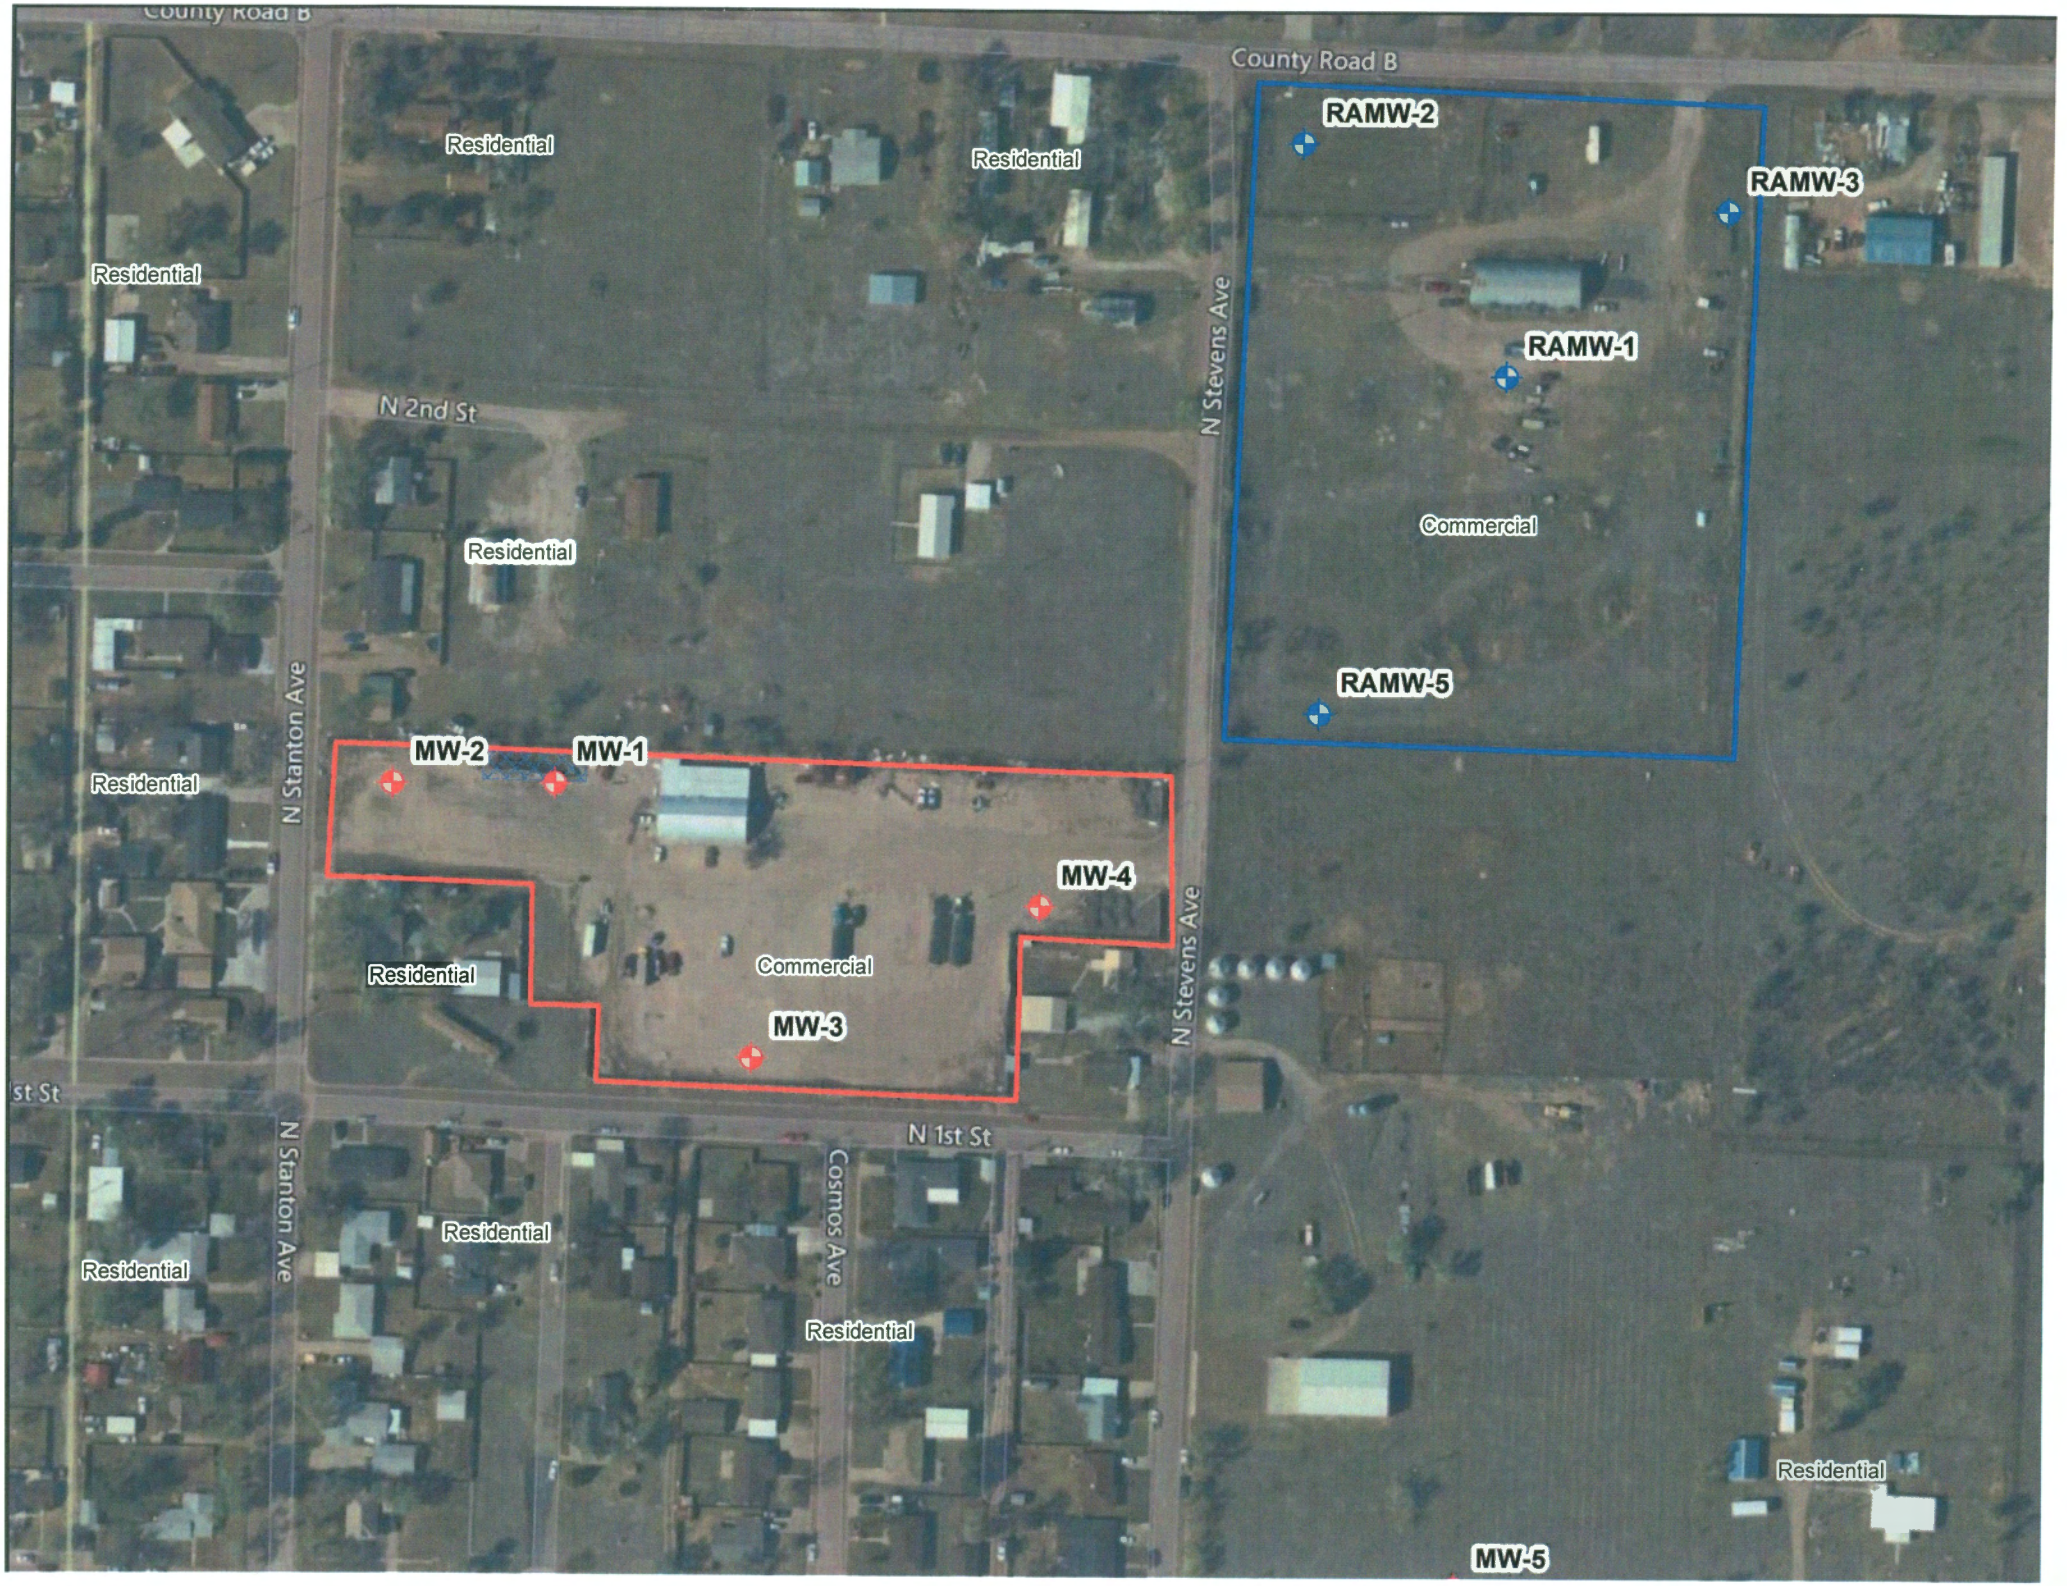
County Road B
RAMW-2
RAMW-3
RAMW-1
RAMW-5
Commercial
Residential
Residential
Residential
Residential
Residential
Residential
N 2nd St
N Stevens Ave
N Stanton Ave
MW-2
MW-1
MW-4
MW-3
Commercial
Residential
N 1st St
Cosmos Ave
Residential
Residential
Residential
Residential
MW-5