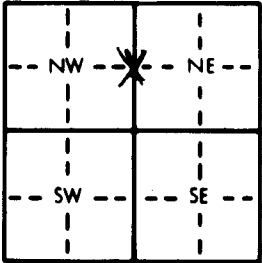
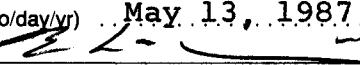


1 LOCATION OF WATER WELL:		Fraction	Section Number	Township Number	Range Number
County: Morton		$\frac{1}{4}$ $\frac{1}{4}$ N C-N $\frac{1}{2}$ $\frac{1}{4}$	10	T 35 S	R 43 EW
Distance and direction from nearest town or city street address of well if located within city? From Elkhart go 4 mi West 1 mi North $\frac{1}{2}$ mi West and South into.					
2 WATER WELL OWNER: Morton County Grazing Association					
RR#, St. Address, Box #: P.O. Box 121					
City, State, ZIP Code: Elkhart, Kansas 67950					
Board of Agriculture, Division of Water Resources					
Application Number:					
3 LOCATE WELL'S LOCATION WITH AN "X" IN SECTION BOX:		4 DEPTH OF COMPLETED WELL: 240 ft. ELEVATION:			
		Depth(s) Groundwater Encountered 1 95 ft. 2. ft. 3. ft.			
		WELL'S STATIC WATER LEVEL 145 ft. below land surface measured on mo/day/yr 4/24/87			
		Pump test data: Well water was ft. after hours pumping gpm			
		Est. Yield 60 gpm: Well water was ft. after hours pumping gpm			
		Bore Hole Diameter 9 in. to 240 ft., and in. to ft.			
WELL WATER TO BE USED AS:					
1 Domestic 3 Feedlot 6 Oil field water supply 9 Dewatering 12 Other (Specify below)					
2 Irrigation 4 Industrial 7 Lawn and garden only 10 Observation well					
Was a chemical/bacteriological sample submitted to Department? Yes.....No.....; If yes, mo/day/yr sample was submitted					
Water Well Disinfected? Yes No					
5 TYPE OF BLANK CASING USED:					
1 Steel 3 RMP (SR) 5 Wrought iron 8 Concrete tile CASING JOINTS: Glued Clamped					
2 PVC 4 ABS 6 Asbestos-Cement 9 Other (specify below) Welded					
7 Fiberglass Threaded					
Blank casing diameter 5 in. to 160 ft., Dia. in. to ft., Dia. in. to ft.					
Casing height above land surface 28 in., weight 2.85 lbs./ft. Wall thickness or gauge No. 265					
TYPE OF SCREEN OR PERFORATION MATERIAL:					
1 Steel 3 Stainless steel 5 Fiberglass 7 PVC 10 Asbestos-cement					
2 Brass 4 Galvanized steel 6 Concrete tile 8 RMP (SR) 11 Other (specify)					
12 None used (open hole)					
SCREEN OR PERFORATION OPENINGS ARE:					
1 Continuous slot 3 Mill slot 5 Gauzed wrapped 8 Saw cut 11 None (open hole)					
2 Louvered shutter 4 Key punched 6 Wire wrapped 9 Drilled holes					
7 Torch cut 10 Other (specify)					
SCREEN-PERFORATED INTERVALS: From 160 ft. to 240 ft., From ft. to ft.					
GRAVEL PACK INTERVALS: From 60 ft. to 240 ft., From ft. to ft.					
6 GROUT MATERIAL: 1 Neat cement 2 Cement grout 3 Bentonite 4 Other					
Grout Intervals: From 0 ft. to 10 ft., From ft. to ft., From ft. to ft.					
What is the nearest source of possible contamination: None					
1 Septic tank 4 Lateral lines 7 Pit privy 10 Livestock pens 14 Abandoned water well					
2 Sewer lines 5 Cess pool 8 Sewage lagoon 11 Fuel storage 15 Oil well/Gas well					
3 Watertight sewer lines 6 Seepage pit 9 Feedyard 12 Fertilizer storage 16 Other (specify below)					
13 Insecticide storage					
Direction from well? How many feet?					
FROM TO LITHOLOGIC LOG FROM TO LITHOLOGIC LOG					
0 2 surface					
2 24 clay					
24 53 sandy clay					
53 68 med. to large sand					
68 73 caliche					
73 104 30% clay & 70% med. sand					
104 146 gipp rock & sandy clay					
146 197 med. to large sand					
197 236 fine sand with spots of clay					
236 240 red bed					
7 CONTRACTOR'S OR LANDOWNER'S CERTIFICATION: This water well was (1) constructed, (2) reconstructed, or (3) plugged under my jurisdiction and was completed on (mo/day/year) April 24, 1987 and this record is true to the best of my knowledge and belief. Kansas					
Water Well Contractor's License No. 118 This Water Well Record was completed on (mo/day/yr) May 13, 1987					
under the business name of Carlile Water Well Service, Inc. by (signature) 					
INSTRUCTIONS: Use typewriter or ball point pen. PLEASE PRESS FIRMLY and PRINT clearly. Please fill in blanks, underline or circle the correct answers. Send top three copies to Kansas Department of Health and Environment, Bureau of Water Protection, Topeka, Kansas 66620-7320, Telephone: 913-862-9360. Send one to WATER WELL OWNER and retain one for your records.					