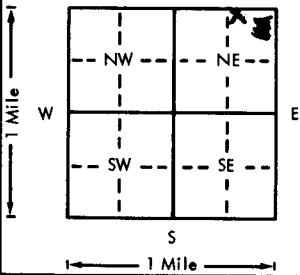


USE TYPEWRITER OR BALL
POINT PEN-PRESS FIRMLY,
PRINT CLEARLY.

WATER WELL RECORD
KSA 82a-1201-1215

Kansas Department of Health and
Environment-Division of Environment
(Water well Contractors)
Topeka, Kansas 66620

| | | | | | | |
|---|--|--|--|---|---|--|
| 1. Location of well: | | County Morton | Fraction NW 1/4 NE 1/4 NE 1/4 | Section number 15 | Township number T 35 S R 43 E/W | Range number 43 |
| 2. Distance and direction from nearest town or city: 3 1/2 mi. West of Elkhart, KS. | | | 3. Owner of well: William F. Penick | | | |
| Street address of well location if in city: | | | R.R. or street: Rt 1 | | | |
| | | | City, state, zip code: Elkhart, Kansas 67950 | | | |
| 4. Locate with "X" in section below: | | Sketch map: | | 6. Bore hole dia. 7 in. Completion date 12/13/76 Well depth 300 ft. | | |
|  | | | | 7. <input checked="" type="checkbox"/> Cable tool <input checked="" type="checkbox"/> Rotary <input type="checkbox"/> Driven <input type="checkbox"/> Dug <input type="checkbox"/> Hollow rod <input type="checkbox"/> Jetted <input type="checkbox"/> Bored <input type="checkbox"/> Reverse rotary | | |
| 5. Type and color of material | | From | | To | | 8. Use: <input checked="" type="checkbox"/> Domestic <input type="checkbox"/> Public supply <input type="checkbox"/> Industry <input type="checkbox"/> Irrigation <input type="checkbox"/> Air conditioning <input type="checkbox"/> Stock <input type="checkbox"/> Lawn <input type="checkbox"/> Oil field water <input type="checkbox"/> Other |
| Overburden | | 0 | | 192 | | 9. Casing: Material PHS Height: Above or below Threaded <input type="checkbox"/> Welded <input checked="" type="checkbox"/> Surface <input type="checkbox"/> in. RMP <input type="checkbox"/> PVC <input checked="" type="checkbox"/> Weight <input type="checkbox"/> lbs./ft. Dia 5 in. to 240 ft. depth Wall Thickness: inches or Dia. <input type="checkbox"/> in. to <input type="checkbox"/> ft. depth gage No. 0-258 |
| Medium Sand + Clay Streaks | | 192 | | 230 | | 10. Screen: Manufacturer's name J+L Type PVC Dia. <input type="checkbox"/> Slot/gauze 7/16 Length 60 Set between 60 ft. and 300 ft. ft. and <input type="checkbox"/> ft. Gravel pack? Yes Size range of material 1/8 |
| Coarse Sand | | 230 | | 297 | | 11. Static water level: <input type="checkbox"/> mo./day/yr. 192 ft. below land surface Date 12/13/76 |
| Tight Clay | | 297 | | 300 | | 12. Pumping level below land surfaces: <input type="checkbox"/> ft. after <input type="checkbox"/> hrs. pumping <input type="checkbox"/> g.p.m. <input type="checkbox"/> ft. after <input type="checkbox"/> hrs. pumping <input type="checkbox"/> g.p.m. Estimated maximum yield 60 g.p.m. |
| | | | | | | 13. Water sample submitted: <input type="checkbox"/> mo./day/yr. <input type="checkbox"/> Yes <input checked="" type="checkbox"/> No Date <input type="checkbox"/> |
| | | | | | | 14. Well head completion: <input type="checkbox"/> Pitless adapter 14 Inches above grade |
| | | | | | | 15. Well grouted? Yes With: <input checked="" type="checkbox"/> Neat cement <input type="checkbox"/> Bentonite <input type="checkbox"/> Concrete Depth: From 3 ft. to 13 ft. |
| | | | | | | 16. Nearest source of possible contamination: ft. 300 Direction NE Type Septic Well disinfected upon completion? <input checked="" type="checkbox"/> Yes <input type="checkbox"/> No |
| | | | | | | 17. Pump: <input checked="" type="checkbox"/> Not installed Manufacturer's name <input type="checkbox"/> Model number <input type="checkbox"/> HP <input type="checkbox"/> Volts <input type="checkbox"/> Length of drop pipe <input type="checkbox"/> ft. capacity <input type="checkbox"/> g.p.m. Type: <input type="checkbox"/> Submersible <input type="checkbox"/> Turbine <input type="checkbox"/> Jet <input type="checkbox"/> Reciprocating <input type="checkbox"/> Centrifugal <input type="checkbox"/> Other |
| | | | | | | 20. Water well contractor's certification: This well was drilled under my jurisdiction and this report is true to the best of my knowledge and belief. T&W Water Well 142 Business name License No. Address Box 816 Liberal, KS Signed C. Wagoner Date 1/4/77 Authorized representative |
| 18. Elevation: | | 19. Remarks: #17 Well to be Completed by: Stout Water Well Service Elkhart, KS 67950 | | | | |
| Topography: <input type="checkbox"/> Hill <input checked="" type="checkbox"/> Slope <input type="checkbox"/> Upland <input type="checkbox"/> Valley | | | | | | |

35 43 E 15
T R W
1/4 1/4 1/4
LINE 116