


1 LOCATION OF WATER WELL: County: Harper Fraction: SE 1/4 SE 1/4 Section Number: 8 Township Number: T 35 S Range Number: R 9 E/W

Distance and direction from nearest town or city street address of well if located within city?
~~1/2 mile S of Hazelton~~ 5 1/2 S 1/2 W Corwin

2 WATER WELL OWNER: Clay Spicer Board of Agriculture, Division of Water Resources
 RR#, St. Address, Box # Hazelton, Kan 67061 Application Number:

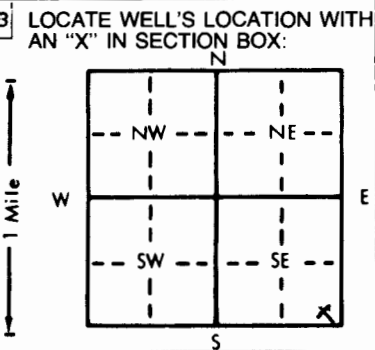

4 DEPTH OF COMPLETED WELL: 101 ft. ELEVATION: _____

Depth(s) Groundwater Encountered 1. 44 ft. 2. 62 ft. 3. _____ ft.

WELL'S STATIC WATER LEVEL 44 ft. below land surface measured on mo/day/yr 12-7-82

Pump test data: Well water was _____ ft. after _____ hours pumping _____ gpm

Est. Yield 3 gpm; Well water was _____ ft. after _____ hours pumping _____ gpm

Bore Hole Diameter 8 in. to 10.1 ft., and _____ in. to _____ ft.

WELL WATER TO BE USED AS:

5 Public water supply	8 Air conditioning	11 Injection well
1 Domestic	3 Feedlot	6 Oil field water supply
2 Irrigation	4 Industrial	7 Lawn and garden only
		10 Observation well

Was a chemical/bacteriological sample submitted to Department? Yes No; If yes, mo/day/yr sample was submitted _____

Water Well Disinfected? Yes Yes No _____

5 TYPE OF BLANK CASING USED:

1 Steel	3 RMP (SR)	5 Wrought iron	8 Concrete tile	CASING JOINTS: <u>Glued</u>
2 <u>PVC</u>	4 ABS	6 Asbestos-Cement	9 Other (specify below)	Clamped _____
		7 Fiberglass		Welded _____
				Threaded _____

Blank casing diameter 4 in. to 9.1 ft., Dia _____ in. to _____ ft., Dia _____ in. to _____ ft.

Casing height above land surface 24 in., weight _____ lbs./ft. Wall thickness or gauge No. 173

TYPE OF SCREEN OR PERFORATION MATERIAL:

1 Steel	3 Stainless steel	5 Fiberglass	7 <u>PVC</u>	10 Asbestos-cement
2 Brass	4 Galvanized steel	6 Concrete tile	8 RMP (SR)	11 Other (specify)
			9 ABS	12 None used (open hole)

SCREEN OR PERFORATION OPENINGS ARE:

1 Continuous slot	3 Mill slot	5 Gauzed wrapped	8 <u>Saw cut</u>	11 None (open hole)
2 Louvered shutter	4 Key punched	6 Wire wrapped	9 Drilled holes	
		7 Torch cut	10 Other (specify)	

SCREEN-PERFORATED INTERVALS: From 91 ft. to 101 ft., From _____ ft. to _____ ft.

GRAVEL PACK INTERVALS: From 10 ft. to 25 ft., From _____ ft. to _____ ft.

6 GROUT MATERIAL: 1 Neat cement 2 Cement grout 3 Bentonite 4 Other

GROUT INTERVALS: From 0 ft. to 10 ft., From _____ ft. to _____ ft., From _____ ft. to _____ ft.

What is the nearest source of possible contamination:

1 Septic tank	4 Lateral lines	7 Pit privy	10 Livestock pens	14 <u>Abandoned water well</u>
2 Sewer lines	5 Cess pool	8 Sewage lagoon	11 Fuel storage	15 Oil well/Gas well
3 Watertight sewer lines	6 Seepage pit	9 Feedyard	12 Fertilizer storage	16 Other (specify below)
			13 Insecticide storage	

Direction from well? N How many feet? 500

FROM	TO	LITHOLOGIC LOG	FROM	TO	LITHOLOGIC LOG
0	4	Soil			
4	101	Shale			

7 CONTRACTOR'S OR LANDOWNER'S CERTIFICATION: This water well was (1) constructed, (2) reconstructed, or (3) plugged under my jurisdiction and was completed on (mo/day/year) 12-15-82 and this record is true to the best of my knowledge and belief. Kansas Water Well Contractor's License No. 140 This Water Well Record was completed on (mo/day/yr) 12-29-82 under the business name of LY man Bros by (signature) Richard Lyman

INSTRUCTIONS: Use typewriter or ball point pen, PLEASE PRESS FIRMLY and PRINT clearly. Please fill in blanks, underline or circle the correct answers. Send top three copies to Kansas Department of Health and Environment, Division of Environment, Environmental Geology Section, Topeka, KS 66620. Send one to WATER WELL OWNER and retain one for your records.

OFFICE USE ONLY T 35 R 9 SEC. 8 SE 1/4 SE 1/4 SE 1/4 SE 1/4