


1 LOCATION OF WATER WELL: Fraction SE 1/4 SW 1/4 NW 1/4 Section Number 10 Township Number T 35 S Range Number R 9 E (W)

Distance and direction from nearest town or city street address of well if located within city? 6 miles north of Omerita, east side of rd.

2 WATER WELL OWNER: Chain Ranch RR#, St. Address, Box #: Canton OK. Board of Agriculture, Division of Water Resources Application Number:

3 LOCATE WELL'S LOCATION WITH AN "X" IN SECTION BOX:

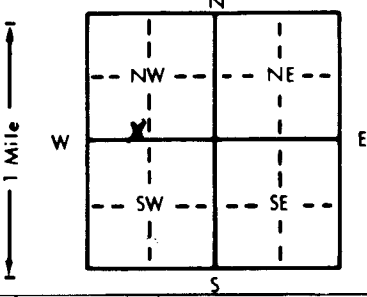

4 DEPTH OF COMPLETED WELL: 42 ft. ELEVATION: Depth(s) Groundwater Encountered 1. 30 ft. 2. WELL'S STATIC WATER LEVEL: 8 ft. below land surface measured on mo/day/yr 3/24/91 Pump test data: Well water was ... ft. after ... hours pumping ... gpm Est. Yield: 20 gpm: Well water was ... ft. after ... hours pumping ... gpm Bore Hole Diameter: 8 1/2 in. to 42 ft., and ... in. to ... ft. WELL WATER TO BE USED AS: 1 Domestic, 2 Irrigation, 3 Feedlot, 4 Industrial, 5 Public water supply, 6 Oil field water supply, 7 Lawn and garden only, 8 Air conditioning, 9 Dewatering, 10 Monitoring well, 11 Injection well, 12 Other (Specify below) Was a chemical/bacteriological sample submitted to Department? Yes No X; If yes, mo/day/yr sample was submitted Water Well Disinfected? Yes No

5 TYPE OF BLANK CASING USED: 1 Steel, 2 PVC, 3 RMP (SR), 4 ABS, 5 Wrought iron, 6 Asbestos-Cement, 7 Fiberglass, 8 Concrete tile, 9 Other (specify below), CASING JOINTS: Glued X, Clamped, Welded, Threaded. Blank casing diameter: 5 in. to 30 ft., Dia. in. to ... ft., Dia. in. to ... ft. Casing height above land surface: 12 in., weight: 160 lbs./ft. Wall thickness or gauge No. TYPE OF SCREEN OR PERFORATION MATERIAL: 1 Steel, 2 Brass, 3 Stainless steel, 4 Galvanized steel, 5 Fiberglass, 6 Concrete tile, 7 PVC, 8 RMP (SR), 9 ABS, 10 Asbestos-cement, 11 Other (specify), 12 None used (open hole) SCREEN OR PERFORATION OPENINGS ARE: 1 Continuous slot, 2 Louvered shutter, 3 Mill slot, 4 Key punched, 5 Gauzed wrapped, 6 Wire wrapped, 7 Torch cut, 8 Saw cut, 9 Drilled holes, 10 Other (specify), 11 None (open hole) SCREEN-PERFORATED INTERVALS: From 30 ft. to 35 ft., From ... ft. to ... ft., From ... ft. to ... ft. GRAVEL PACK INTERVALS: From 10 ft. to 42 ft., From ... ft. to ... ft., From ... ft. to ... ft.

6 GROUT MATERIAL: 1 Neat cement, 2 Cement grout, 3 Bentonite, 4 Other Grout Intervals: From 0 ft. to 10 ft., From ... ft. to ... ft., From ... ft. to ... ft. What is the nearest source of possible contamination: 1 Septic tank, 2 Sewer lines, 3 Watertight sewer lines, 4 Lateral lines, 5 Cess pool, 6 Seepage pit, 7 Pit privy, 8 Sewage lagoon, 9 Feedyard, 10 Livestock pens, 11 Fuel storage, 12 Fertilizer storage, 13 Insecticide storage, 14 Abandoned water well, 15 Oil well/Gas well, 16 Other (specify below) Direction from well? How many feet?

FROM	TO	LITHOLOGIC LOG	FROM	TO	PLUGGING INTERVALS
0	10	lanky topsoil			
10	20	light clay			
20	25	coarse sand			
25	35	coarser gravel			
35	42	Red Bed			

7 CONTRACTOR'S OR LANDOWNER'S CERTIFICATION: This water well was (1) constructed, (2) reconstructed, or (3) plugged under my jurisdiction and was completed on (mo/day/year) 3-24-91 and this record is true to the best of my knowledge and belief. Kansas Water Well Contractor's License No. 141. This Water Well Record was completed on (mo/day/yr) 6-24-91 under the business name of Lehman by (signature) Carl Zell

OFFICE USE ONLY T R EW SEC. 1/4 1/4 1/4 1/4