


USE TYPEWRITER OR BALL POINT PEN-PRESS FIRMLY, PRINT CLEARLY.

WATER WELL RECORD  
KSA 82a-1201-1215

Kansas Department of Health and Environment-Division of Environment (Water well Contractors) Topeka, Kansas 66620

1. Location of well: County Republic Fraction SE 1/4 SE 1/4 NE 1/4 Section number 5 Township number T 35 S R 1W E/W

2. Distance and direction from nearest town or city: 36 Miles Cuba Street address of well location if in city: Turn off 45 1/2 east NSR 3. Owner of well: Glenn Henke R.R. or street: R.R. City, state, zip code: Cuba, Kans. 66940

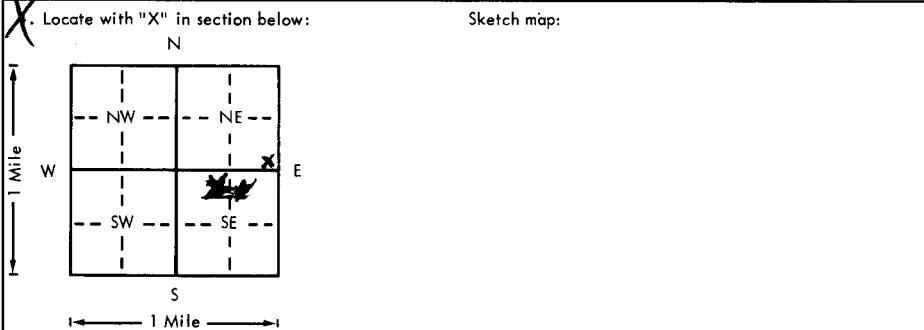

6. Bore hole dia. 8 in. Completion date 5-1-79  
Well depth 102 ft.

7.  Cable tool  Rotary  Driven  Dug  
 Hollow rod  Jetted  Bored  Reverse rotary

8. Use:  Domestic  Public supply  Industry  
 Irrigation  Air conditioning  Stock  
 Lawn  Oil field water  Other

Casing: Material PVC  Height: Above or below  
Threaded  Welded  Surface 12 in.  
RMP  PVC  Weight 200 lbs./ft.  
Dia. 5 in. to 102 ft. depth  All Thickness: inches or  
Dia.  in. to  ft. depth gage No. 1200

5. Type and color of material	From	To
Soil top	0	2
clay tan	2	5
Limestone soft	5	6
clay sandy yellow	6	25
clay Blue	25	30
shale Blue	30	45
sand rock hard	45	46
shale	46	56
sand rock fine in shale	56	75
shale	75	80
Rock sand shaley	80	85
shale	85	96
Rock limestone	96	97
shale white	97	102

Screen: Manufacturer's name Plastic  
NSF apparatus # 200  
Type Plastic Dia. 5 in.  
Slot/gauze 060 Length 40  
Set between 54 ft. and 94 ft.  
 Gravel pack?  Size range of material 1/4 in.

11. Static water level: 58 ft. below land surface Date 5-1-79 mo./day/yr.

12. Pumping level below land surfaces:  
 ft. after  hrs. pumping  g.p.m.  
 ft. after  hrs. pumping  g.p.m.  
Estimated maximum yield  g.p.m.

13. Water sample submitted:  Yes  No Date

Well head completion: capped  
 Pitless adapter  Inches above grade

15. Well grouted? yes  
With:  Neat cement  Bentonite  Concrete  
Depth: From 0 ft. to 20 ft.

Nearest source of possible contamination: none  
ft. Direction Type  
Well disinfected upon completion?  Yes  No

17. Pump:  Not installed  
Manufacturer's name  
Model number HP Volts  
Length of drop pipe  ft. capacity  g.p.m.  
Type:  
 Submersible  Turbine  
 Jet  Reciprocating  
 Centrifugal  Other

18. Elevation: 1490 ft  
Topography:  Hill  Slope  Upland  Valley

19. Remarks:

20. Water well contractor's certification:  
This well was drilled under my jurisdiction and this report is true to the best of my knowledge and belief.  
Blue Valley Drilling 234D  
Business name License No.  
Address Blue Rapids, Mo 66411  
Signed Arnold Strader Date 5-15-79  
Authorized representative