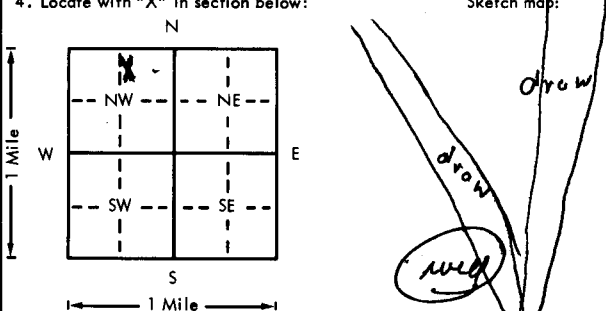


USE TYPEWRITER OR BALL
POINT PEN-PRESS FIRMLY,
PRINT CLEARLY.

WATER WELL RECORD
KSA 82a-1201-1215

Kansas Department of Health and
Environment-Division of Environment
(Water well Contractors)
Topeka, Kansas 66620

1. Location of well:		County Jewell	Fraction NE 1/4 NE 1/4 NW 1/4	Section number 10	Township number T 3	Range number S R 10 E
2. Distance and direction from nearest town or city: Street address of well location if in city:		1/4 S 1/4 W of Esbon		3. Owner of well: Everett Benoit R.R. or street: City, state, zip code: Esbon KS		
4. Locate with "X" in section below: 		6. Bore hole dia. 2 in. Completion date 6-11-77 Well depth 35 ft.				
5. Type and color of material		7. <input checked="" type="checkbox"/> Cable tool <input checked="" type="checkbox"/> Rotary <input type="checkbox"/> Driven <input type="checkbox"/> Dug <input type="checkbox"/> Hollow rod <input type="checkbox"/> Jetted <input type="checkbox"/> Bored <input type="checkbox"/> Reverse rotary				
Top soil & clay		8. Use: <input type="checkbox"/> Domestic <input type="checkbox"/> Public supply <input type="checkbox"/> Industry <input type="checkbox"/> Irrigation <input type="checkbox"/> Air conditioning <input checked="" type="checkbox"/> Stock <input type="checkbox"/> Lawn <input type="checkbox"/> Oil field water <input type="checkbox"/> Other				
broken rocks & clay		9. Casing: Material PVC Height: Above or below Threaded <input type="checkbox"/> Welded <input type="checkbox"/> Surface 24 in. RMP <input type="checkbox"/> PVC <input checked="" type="checkbox"/> Weight <input type="checkbox"/> lbs./ft.				
Shale		Dia. 5 in. to 35 ft. depth Wall Thickness: inches or Dia. <input type="checkbox"/> in. to <input type="checkbox"/> ft. depth Gauge No. 190				
		10. Screen: Manufacturer's name Pumpco Supply Type Slotted PVC Dia. 5" Slot gauge 0030 Length 23 Set between 12 ft. and 35 ft. Gravel pack? yes Size range of material fine-3/4"				
		11. Static water level: <input type="checkbox"/> mo./day/yr. 11 ft. below land surface Date 6-11-77				
		12. Pumping level below land surfaces: 25 ft. after 1 hrs. pumping 5 g.p.m. ft. after <input type="checkbox"/> hrs. pumping <input type="checkbox"/> g.p.m. Estimated maximum yield 5 g.p.m.				
		13. Water sample submitted: <input type="checkbox"/> mo./day/yr. <input type="checkbox"/> Yes <input checked="" type="checkbox"/> No Date <input type="checkbox"/>				
		14. Well head completion: <input type="checkbox"/> Pitless adapter 24 inches above grade				
		15. Well grouted? yes With: <input type="checkbox"/> Neat cement <input checked="" type="checkbox"/> Bentonite <input type="checkbox"/> Concrete Depth: From 0 ft. to 10 ft.				
		16. Nearest source of possible contamination: ft. 75 Direction E Type draw Well disinfected upon completion? <input checked="" type="checkbox"/> Yes <input type="checkbox"/> No				
		17. Pump: <input checked="" type="checkbox"/> Not installed Manufacturer's name <input type="checkbox"/> Model number <input type="checkbox"/> HP <input type="checkbox"/> Volts <input type="checkbox"/> Length of drop pipe <input type="checkbox"/> ft. capacity <input type="checkbox"/> g.p.m. Type: <input type="checkbox"/> Submersible <input type="checkbox"/> Turbine <input type="checkbox"/> Jet <input type="checkbox"/> Reciprocating <input type="checkbox"/> Centrifugal <input type="checkbox"/> Other				
18. Elevation:		19. Remarks:				
Topography: <input type="checkbox"/> Hill <input type="checkbox"/> Slope <input type="checkbox"/> Upland <input checked="" type="checkbox"/> Valley		20. Water well contractor's certification: This well was drilled under my jurisdiction and this report is true to the best of my knowledge and belief. Maruhn Well Drilling 165 Business name Red Cloud Ne License No. <input type="checkbox"/> Address Law Maruhn Date 6-8-77 Signed <input type="checkbox"/> Authorized representative				