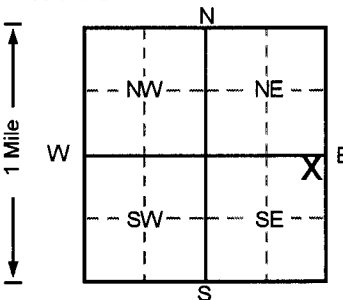


1 LOCATION OF WATER WELL: Fraction **NE ¼ NE ¼ SE ¼** Section Number **9** Township Number **T 3 S** Range Number **R 11 EW**  
 County: **Smith**

Distance and direction from nearest town or city street address of well if located within city?  
**800' S of Lebanon City Limits on HWY 281**

2 WATER WELL OWNER: **Independent Oil Co.**  
 RR#, St. Address, Box # : **RR2, Box 2490** Board of Agriculture, Division of Water Resources  
 City, State, ZIP Code : **Fairplay, Missouri 65649** Application Number:

3 LOCATE WELL'S LOCATION WITH AN "X" IN SECTION BOX: 

4 DEPTH OF COMPLETED WELL ..... **25** ..... ft. ELEVATION: ..... **1821.59** .....  
 Depth(s) Groundwater Encountered 1. .... **24** ..... ft. 2. .... ft. 3. .... ft.  
 WELL'S STATIC WATER LEVEL ... **24.63** ... ft. below land surface measured on mo/day/yr ..... **2/5/96** .....  
 Pump test data: Well water was ... **NA** ... ft. after ..... hours pumping ..... gpm  
 Est. Yield ... **NA** ... gpm: Well water was ..... ft. after ..... hours pumping ..... gpm  
 Bore Hole Diameter ... **8** ... in. to ..... **25** ..... ft., and ..... in. to ..... ft.  
 WELL WATER TO BE USED AS: 5 Public water supply 8 Air conditioning 11 Injection well  
 1 Domestic 3 Feedlot 6 Oil field water supply 9 Dewatering 12 Other (Specify below)  
 2 Irrigation 4 Industrial 7 Lawn and garden only **10** Monitoring well  
 Was a chemical/bacteriological sample submitted to Department? Yes.....No.....; If yes, mo/day/yr sample was submitted  
 Water Well Disinfected? Yes No

5 TYPE OF BLANK CASING USED:  
 1 Steel 2 PVC **2** 3 RMP (SR) 4 ABS 5 Wrought iron 6 Asbestos-Cement 7 Fiberglass 8 Concrete tile 9 Other (specify below) CASING JOINTS: Glued ..... Clamped .....  
 Blank casing diameter ..... **2** ..... in. to ..... **15** ..... ft., Dia ..... in. to ..... ft., Dia ..... in. to ..... ft.  
 Casing height above land surface ..... **28.92** ..... in., weight ..... lbs./ft. Wall thickness or gauge No. .... **Sch. 40** .....  
 TYPE OF SCREEN OR PERFORATION MATERIAL **7** PVC 10 Asbestos-cement  
 1 Steel 2 Brass 3 Stainless steel 4 Galvanized steel 5 Fiberglass 6 Concrete tile 7 RMP (SR) 8 ABS 9 Other (specify) .....  
 11 None used (open hole)  
 SCREEN OR PERFORATION OPENINGS ARE:  
 1 Continuous slot 2 Louvered shutter 3 Mill slot **3** 4 Key punched 5 Gauzed wrapped 6 Wire wrapped 7 Torch cut 8 Saw cut 9 Drilled holes 10 Other (specify) .....  
 11 None (open hole)  
 SCREEN-PERFORATED INTERVALS: From ..... **15** ..... ft. to ..... **25** ..... ft., From ..... ft. to ..... ft.  
 GRAVEL PACK INTERVALS: From ..... **13** ..... ft. to ..... **25** ..... ft., From ..... ft. to ..... ft.  
 From ..... ft. to ..... ft., From ..... ft. to ..... ft.

6 GROUT MATERIAL: 1 Neat cement 2 Cement grout **2** 3 Bentonite 4 Other .....  
 Grout Intervals: From ..... **0** ..... ft. to ..... **11** ..... ft., From ..... **11** ..... ft. to ..... **13** ..... ft., From ..... ft. to ..... ft.  
 What is the nearest source of possible contamination:  
 1 Septic tank 2 Sewer lines 3 Watertight sewer lines 4 Lateral lines 5 Cess pool 6 Seepage pit 7 Pit privy 8 Sewage lagoon 9 Feedyard 10 Livestock pens 11 Fuel storage 12 Fertilizer storage 13 Insecticide storage 14 Abandoned water well 15 Oil well/Gas well 16 Other (specify below) **16** **Former UST Basin** ...  
 Direction from well? **SE** How many feet? **220**

FROM	TO	LITHOLOGIC LOG	FROM	TO	PLUGGING INTERVALS
0	1	Topsoil, Light Brown			
1	3	Clay, Light Brown			
3	5	Silt, Light Yellow Brown			
5	7	Clay, Light Brown			
7	8	Clay, Dark Brown			
8	12	Clay, Medium to Dark Brown			
12	15	Clay, Light Orange			
15	20	Sand, Light Yellow Brown			
20	25	Shale, Light Yellow Brown			
					MW10, Tag # 00140229, Abovegrade
					Project Name: Independent Oil
					GeoCore # 100, KDHE # U6 092 533

7 CONTRACTOR'S OR LANDOWNER'S CERTIFICATION: This water well was **(1)** constructed, (2) reconstructed, or (3) plugged under my jurisdiction and was completed on (mo/day/year) ..... **1/30/96** ..... and this record is true to the best of my knowledge and belief.  
 Kansas Water Well Contractor's License No. .... **527** ..... This Water Well Record was completed on (mo/day/yr) ..... **2/22/96** .....  
 under the business name of **GeoCore Services, Inc.** by (signature) *Dale A. Holt*