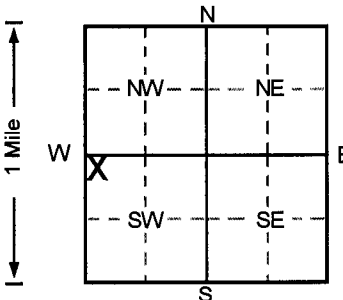


1 LOCATION OF WATER WELL: County: Smith	Fraction NW 1/4 NW 1/4 SW 1/4	Section Number 10	Township Number T 3 S	Range Number R 11 E/W
---	---	-----------------------------	---------------------------------	---------------------------------

Distance and direction from nearest town or city street address of well if located within city?
800' S of Lebanon City Limits on HWY 281

2 WATER WELL OWNER: **Independent Oil Co.**
 RR#, St. Address, Box # : **RR2, Box 2490**
 City, State, ZIP Code : **Fairplay, Missouri 65649**
 Board of Agriculture, Division of Water Resources
 Application Number:

3 LOCATE WELL'S LOCATION WITH AN "X" IN SECTION BOX: 	4 DEPTH OF COMPLETED WELL 28 ft. ELEVATION: 1824.76 Depth(s) Groundwater Encountered 1. 24 ft. 2. ft. 3. ft. WELL'S STATIC WATER LEVEL ft. below land surface measured on mo/day/yr Pump test data: Well water was NA ft. after hours pumping gpm Est. Yield .. NA .. gpm: Well water was ft. after hours pumping gpm Bore Hole Diameter 8 in. to 28 ft., and in. to ft. WELL WATER TO BE USED AS: 5 Public water supply 8 Air conditioning 11 Injection well 1 Domestic 3 Feedlot 6 Oil field water supply 9 Dewatering 12 Other (Specify below) 2 Irrigation 4 Industrial 7 Lawn and garden only 10 Monitoring well Was a chemical/bacteriological sample submitted to Department? Yes.....No.....; If yes, mo/day/yr sample was submitted Water Well Disinfected? Yes No <input checked="" type="checkbox"/>
--	--

5 TYPE OF BLANK CASING USED:
 1 Steel 2 PVC **2** 3 RMP (SR) 4 ABS 5 Wrought iron 6 Asbestos-Cement 7 Fiberglass 8 Concrete tile 9 Other (specify below) CASING JOINTS: Glued Clamped
 Welded Threaded.
 Blank casing diameter **2** in. to **18** ft., Dia in. to ft., Dia in. to ft.
 Casing height above land surface **4.32** in., weight lbs./ft. Wall thickness or gauge No. **Sch. 40**
 TYPE OF SCREEN OR PERFORATION MATERIAL
 1 Steel 2 Brass 3 Stainless steel 4 Galvanized steel 5 Fiberglass 6 Concrete tile 7 PVC **7** 8 RMP (SR) 9 ABS 10 Asbestos-cement 11 Other (specify) 12 None used (open hole)
 SCREEN OR PERFORATION OPENINGS ARE:
 1 Continuous slot 2 Louvered shutter 3 Mill slot **3** 4 Key punched 5 Gauzed wrapped 6 Wire wrapped 7 Torch cut 8 Saw cut 9 Drilled holes 10 Other (specify) 11 None (open hole)
 SCREEN-PERFORATED INTERVALS: From **18** ft. to **28** ft., From ft. to ft.
 GRAVEL PACK INTERVALS: From **16** ft. to **28** ft., From ft. to ft.

6 GROUT MATERIAL: 1 Neat cement 2 Cement grout **2** 3 Bentonite 4 Other
 Grout Intervals: From **0** ft. to **14** ft., From **14** ft. to **16** ft., From ft. to ft.
 What is the nearest source of possible contamination:
 1 Septic tank 2 Sewer lines 3 Watertight sewer lines 4 Lateral lines 5 Cess pool 6 Seepage pit 7 Pit privy 8 Sewage lagoon 9 Feedyard 10 Livestock pens 11 Fuel storage 12 Fertilizer storage 13 Insecticide storage 14 Abandoned water well 15 Oil well/Gas well **16** Other (specify below) **Former UST Basin**
 Direction from well? **SE** How many feet? **180**

FROM	TO	LITHOLOGIC LOG	FROM	TO	PLUGGING INTERVALS
0	0.5	Fill,			
0.5	2	Clay, Medium Brown			
2	3	Clay, Medium Brown			
3	5	Silt, Light Yellow Brown			
5	8	Clay, Light to Medium Brown			
8	12	Clay, Dark Brown			
12	15	Clay, Medium Orange Brown			
15	17	Clay, Light Orange Brown			
17	20	Sand, Light Yellow Brown			
20	24	Shale, Light Yellow Brown			
24	28	Shale, Medium Yellow Brown			
					MW12, Tag # 00140243, Flushmount
					Project Name: Independent Oil
					GeoCore # 100, KDHE # U6 092 533

7 CONTRACTOR'S OR LANDOWNER'S CERTIFICATION: This water well was **(1)** constructed, (2) reconstructed, or (3) plugged under my jurisdiction and was completed on (mo/day/year) **1/31/96** and this record is true to the best of my knowledge and belief.
 Kansas Water Well Contractor's License No. **527** This Water Well Record was completed on (mo/day/yr) **2/22/96**
 under the business name of **GeoCore Services, Inc.** by (signature) *Dale A. Rob*

INSTRUCTIONS: Use typewriter or ball point pen. PLEASE PRESS FIRMLY and PRINT clearly. Please fill in blanks, underline or circle the correct answers. Send top three copies to Kansas Department of Health and Environment, Bureau of Water, Topeka, Kansas 66620-0001. Telephone: 913-296-5545. Send one to WATER WELL OWNER and retain one for your records.