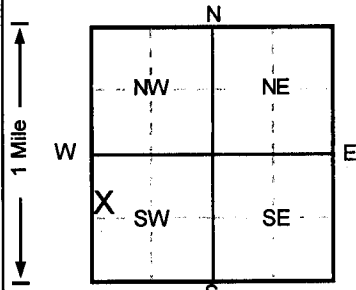


1 LOCATION OF WATER WELL: County: <b>Smith</b>	Fraction <b>SW ¼ NW ¼ SW ¼</b>	Section Number <b>10</b>	Township Number <b>T 3 S</b>	Range Number <b>R 11 E/W</b>
---	-----------------------------------	-----------------------------	---------------------------------	---------------------------------

Distance and direction from nearest town or city street address of well if located within city?  
**800' S of Lebanon City Limits on HWY 281**

2 WATER WELL OWNER: **Independent Oil Co.**  
 RR#, St. Address, Box # : **RR2, Box 2490** Board of Agriculture, Division of Water Resources  
 City, State, ZIP Code : **Fairplay, Missouri 65649** Application Number:

3 LOCATE WELL'S LOCATION WITH AN "X" IN SECTION BOX: 	4 DEPTH OF COMPLETED WELL . . . . . <b>25</b> . . . . . ft. ELEVATION: . . . . . <b>1822.63</b>
	Depth(s) Groundwater Encountered 1. . . . . <b>21.2</b> . . . . . ft. 2. . . . . ft. 3. . . . . ft. WELL'S STATIC WATER LEVEL . . . . . <b>23.71</b> . . . . . ft. below land surface measured on mo/day/yr . . . . . <b>2/1/96</b> Pump test data: Well water was . . . . . ft. after . . . . . hours pumping . . . . . gpm Est. Yield . . . <b>NA</b> . . . gpm: Well water was . . . . . ft. after . . . . . hours pumping . . . . . gpm Bore Hole Diameter . . . . . <b>8</b> . . . . . in. to . . . . . <b>25</b> . . . . . ft. and . . . . . in. to . . . . . ft. WELL WATER TO BE USED AS: 5 Public water supply 8 Air conditioning 11 Injection well 1 Domestic 3 Feedlot 6 Oil field water supply 9 Dewatering 12 Other (Specify below) 2 Irrigation 4 Industrial 7 Lawn and garden only <b>10 Monitoring well</b> Was a chemical/bacteriological sample submitted to Department? Yes.....No <input checked="" type="checkbox"/> ; If yes, mo/day/yr sample was submitted Water Well Disinfected? Yes No <input checked="" type="checkbox"/>

5 TYPE OF BLANK CASING USED: 5 Wrought iron 8 Concrete tile CASING JOINTS: Glued . . . . . Clamped . . . . .  
 1 Steel 3 RMP (SR) 6 Asbestos-Cement 9 Other (specify below) Welded . . . . .  
**2 PVC** 4 ABS 7 Fiberglass . . . . . Threaded . . . . .  
 Blank casing diameter . . . . . **2** . . . . . in. to . . . . . **10** . . . . . ft. Dia . . . . . in. to . . . . . ft. Dia . . . . . in. to . . . . . ft.  
 Casing height above land surface . . . . . **30** . . . . . in., weight . . . . . **Sch. 40** . . . . . lbs./ft. Wall thickness or gauge No. . . . .  
 TYPE OF SCREEN OR PERFORATION MATERIAL **7 PVC** 10 Asbestos-cement  
 1 Steel 3 Stainless steel 5 Fiberglass **8 RMP (SR)** 11 Other (specify) . . . . .  
 2 Brass 4 Galvanized steel 6 Concrete tile 9 ABS 12 None used (open hole)  
 SCREEN OR PERFORATION OPENINGS ARE: 5 Gauzed wrapped 8 Saw cut 11 None (open hole)  
 1 Continuous slot 3 Mill slot 6 Wire wrapped 9 Drilled holes  
 2 Louvered shutter 4 Key punched 7 Torch cut 10 Other (specify) . . . . .  
 SCREEN-PERFORATED INTERVALS: From . . . . . **10** . . . . . ft. to . . . . . **25** . . . . . ft. From . . . . . ft. to . . . . . ft.  
 From . . . . . ft. to . . . . . ft. From . . . . . ft. to . . . . . ft.  
 GRAVEL PACK INTERVALS: From . . . . . **8** . . . . . ft. to . . . . . **25** . . . . . ft. From . . . . . ft. to . . . . . ft.  
 From . . . . . ft. to . . . . . ft. From . . . . . ft. to . . . . . ft.

6 GROUT MATERIAL: 1 Neat cement **2 Cement grout** **3 Bentonite** 4 Other . . . . .  
 Grout Intervals: From . . . . . **6** . . . . . ft. to . . . . . **8** . . . . . ft. From . . . . . **0** . . . . . ft. to . . . . . **6** . . . . . ft. From . . . . . ft. to . . . . . ft.  
 What is the nearest source of possible contamination:  
 1 Septic tank 4 Lateral lines 7 Pit privy 10 Livestock pens 14 Abandoned water well  
 2 Sewer lines 5 Cess pool 8 Sewage lagoon 11 Fuel storage 15 Oil well/Gas well  
 3 Watertight sewer lines 6 Seepage pit 9 Feedyard 12 Fertilizer storage **16 Other (specify below)**  
 . . . . . **UST Basin** . . . . .  
 Direction from well? **ENE** How many feet? **150**

FROM	TO	LITHOLOGIC LOG	FROM	TO	PLUGGING INTERVALS
0	2	Clay, Doark Brown			
2	10	Silt, Light Yellow-Brown			
10	14	Clay, Dark Brown			
14	17	Clay, Medium Orange-Brown			
17	18	Clay, Light Yellow-Brown			
18	21	Sand, Medium Yellow-Brown			
21	25	Shale, Light Yellow-Brown, Dark Brown			
					MW9, Tag # 00126438, Abovegrade
					Project Name: Independent Oil
					GeoCore # 100, KDHE # U6 092 494

7 CONTRACTOR'S OR LANDOWNER'S CERTIFICATION: This water well was **(1)** constructed, (2) reconstructed, or (3) plugged under my jurisdiction and was completed on (mo/day/year) . . . . . **3/14/95** . . . . . and this record is true to the best of my knowledge and belief.  
 Kansas Water Well Contractor's License No. . . . . **527** . . . . . This Water Well Record was completed on (mo/day/yr) . . . . .  
 under the business name of **GeoCore Services, Inc.** by (signature) **Dale Noble**