

MW6


1 LOCATION OF WATER WELL: County: SMITH	Fraction SW 1/4 SE 1/4 NW 1/4	Section Number 10	Township Number T 3 S	Range Number R 11 E 12
---	---	-----------------------------	---------------------------------	---

Distance and direction from nearest town or city street address of well if located within city?

511 MAIN STREET, LEBMON, KS

2 WATER WELL OWNER: PETERSON OIL COMPANY	Board of Agriculture, Division of Water Resources
RR#, St. Address, Box #: PO BOX 367	Application Number:
City, State, ZIP Code: RED CLOUD, NE 68970	

3 LOCATE WELL'S LOCATION WITH AN "X" IN SECTION BOX:

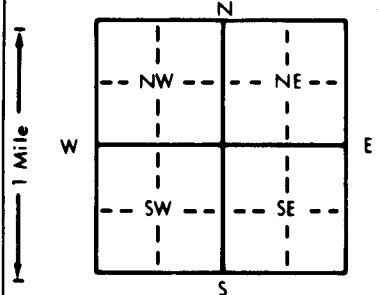

4 DEPTH OF COMPLETED WELL: 16 ft.	ELEVATION:			
Depth(s) Groundwater Encountered: 1. 13 ft. 2. ft. 3. ft.				
WELL'S STATIC WATER LEVEL: 13.04 ft. below land surface measured on mo/day/yr 5/6/98				
Pump test data: Well water was ft. after hours pumping gpm				
Est. Yield gpm: Well water was ft. after hours pumping gpm				
Bore Hole Diameter: 8.5 in. to 16 ft., and in. to ft.				
WELL WATER TO BE USED AS:				
5 Public water supply	8 Air conditioning	11 Injection well		
1 Domestic	3 Feedlot	6 Oil field water supply	9 Dewatering	12 Other (Specify below)
2 Irrigation	4 Industrial	7 Lawn and garden only	10 Monitoring well	
Was a chemical/bacteriological sample submitted to Department? Yes No X ; If yes, mo/day/yr sample was submitted	Water Well Disinfected? Yes No			

5 TYPE OF BLANK CASING USED:	5 Wrought iron	8 Concrete tile	CASING JOINTS: Glued Clamped	
1 Steel	3 RMP (SR)	6 Asbestos-Cement	9 Other (specify below)	Welded
PVC	4 ABS	7 Fiberglass		Threaded
Blank casing diameter: 2 in. to 6 ft., Dia. in. to ft., Dia. in. to ft.				
Casing height above land surface: 28 in., weight 2.073 lbs./ft. Wall thickness or gauge No. 0.13				
TYPE OF SCREEN OR PERFORATION MATERIAL:			10 Asbestos-cement	
1 Steel	3 Stainless steel	5 Fiberglass	8 RMP (SR)	11 Other (specify)
2 Brass	4 Galvanized steel	6 Concrete tile	9 ABS	12 None used (open hole)
SCREEN OR PERFORATION OPENINGS ARE:			8 Saw cut	11 None (open hole)
1 Continuous slot	3 Mill slot	5 Gauzed wrapped	9 Drilled holes	
2 Louvered shutter	4 Key punched	6 Wire wrapped	10 Other (specify)	
SCREEN-PERFORATED INTERVALS:				
From 6 ft. to 16 ft., From ft. to ft.				
GRAVEL PACK INTERVALS:				
From 4 ft. to 16 ft., From ft. to ft.				

6 GROUT MATERIAL:	1 Neat cement	2 Cement grout	3 Bentonite	4 Other
Grout Intervals: From 2 ft. to 4 ft., From ft. to ft.				
What is the nearest source of possible contamination:			10 Livestock pens	14 Abandoned water well
1 Septic tank	4 Lateral lines	7 Pit privy	11 Fuel storage	15 Oil well/Gas well
2 Sewer lines	5 Cess pool	8 Sewage lagoon	12 Fertilizer storage	16 Other (specify below)
3 Watertight sewer lines	6 Seepage pit	9 Feedyard	13 Insecticide storage	
Direction from well? NW			How many feet? 165	

FROM	TO	LITHOLOGIC LOG	FROM	TO	PLUGGING INTERVALS
0	16	SILTY CLAY			

7 CONTRACTOR'S OR LANDOWNER'S CERTIFICATION: This water well was **(1) constructed**, (2) reconstructed, or (3) plugged under my jurisdiction and was completed on (mo/day/year) **5/5/98** and this record is true to the best of my knowledge and belief. Kansas Water Well Contractor's License No. **594**. This Water Well Record was completed on (mo/day/yr) **5/6/98** under the business name of **CORANO-GRANT PLANS** by (signature) *[Signature]*

INSTRUCTIONS: Use typewriter or ball point pen. PLEASE PRESS FIRMLY and PRINT clearly. Please fill in blanks, underline or circle the correct answers. Send top three copies to Kansas Department of Health and Environment, Bureau of Water, Topeka, Kansas 66620-0001. Telephone: 913-296-5545. Send one to WATER WELL OWNER and retain one for your records.

OFFICE USE ONLY
T
R
EW
SEC