


1 LOCATION OF WATER WELL: County: Smith Fraction: SW 1/4 SW 1/4 SE 1/4 Section Number: 17 Township Number: T 3 S Range Number: R 11 E/W

Distance and direction from nearest town or city street address of well if located within city?  
2.5 1/2 W Lebanon Ks

2 WATER WELL OWNER: Rodney Richardson  
RR#, St. Address, Box #: RT 1 Box 66 Board of Agriculture, Division of Water Resources  
City, State, ZIP Code: Lebanon Ks 66952 Application Number:

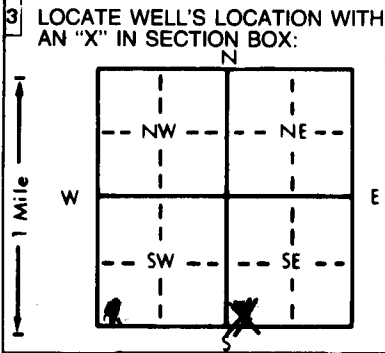

4 DEPTH OF COMPLETED WELL: 106 ft. ELEVATION:  
Depth(s) Groundwater Encountered 1. 3 ft. 2. ft. 3. ft.  
WELL'S STATIC WATER LEVEL 3 ft. below land surface measured on mo/day/yr 8-10-92  
Pump test data: Well water was 9.6 ft. after 1 hours pumping 7 gpm  
Est. Yield 7 gpm: Well water was ft. after hours pumping gpm  
Bore Hole Diameter 8 in. to 10.6 ft., and in. to ft.  
WELL WATER TO BE USED AS: 5 Public water supply 8 Air conditioning 11 Injection well  
1 Domestic 3 Feedlot 6 Oil field water supply 9 Dewatering 12 Other (Specify below)  
2 Irrigation 4 Industrial 7 Lawn and garden only 10 Monitoring well  
Was a chemical/bacteriological sample submitted to Department? Yes No X; If yes, mo/day/yr sample was submitted  
Water Well Disinfected? Yes X No

5 TYPE OF BLANK CASING USED: 1 Steel 3 RMP (SR) 5 Wrought iron 8 Concrete tile CASING JOINTS: Glued X Clamped  
2 PVC 4 ABS 6 Asbestos-Cement 9 Other (specify below) Welded  
7 Fiberglass Threaded  
Blank casing diameter 5 in. to 6 ft., Dia 5 in. to 26-40 ft., Dia 5 in. to 60-80 ft.  
Casing height above land surface 12 in., weight 229 CFT lbs./ft. Wall thickness or gauge No. 214  
TYPE OF SCREEN OR PERFORATION MATERIAL: 1 Steel 3 Stainless steel 5 Fiberglass 8 RMP (SR) 10 Asbestos-cement  
2 Brass 4 Galvanized steel 6 Concrete tile 9 ABS 11 Other (specify)  
12 None used (open hole)  
SCREEN OR PERFORATION OPENINGS ARE: 1 Continuous slot 3 Mill slot 5 Gauzed wrapped 8 Saw cut 11 None (open hole)  
2 Louvered shutter 4 Key punched 6 Wire wrapped 9 Drilled holes  
7 Torch cut 10 Other (specify)  
SCREEN-PERFORATED INTERVALS: From 6 ft. to 26 ft., From 40-60 ft. to 80-100 ft.  
GRAVEL PACK INTERVALS: From 6 ft. to 106 ft., From ft. to ft.

6 GROUT MATERIAL: 1 Neat cement 2 Cement grout 3 Bentonite 4 Other hole plug  
Grout Intervals: From 0 ft. to 6 ft., From ft. to ft. to ft.  
What is the nearest source of possible contamination: 1 Septic tank 4 Lateral lines 7 Pit privy 10 Livestock pens 14 Abandoned water well  
2 Sewer lines 5 Cess pool 8 Sewage lagoon 11 Fuel storage 15 Oil well/Gas well  
3 Watertight sewer lines 6 Seepage pit 9 Feedyard 12 Fertilizer storage 16 Other (specify below)  
13 Insecticide storage  
Direction from well? SW How many feet? 100+

FROM	TO	LITHOLOGIC LOG	FROM	TO	PLUGGING INTERVALS
0	5	Top Soil & Clay			
5	13	broken rock & clay			
13	65	Shale light blue			
65	95	Shale grey w/ strips of blue shale			
95	99	Shale w lot of small fragments felt gritty			
99	120	Shale blue			

7 CONTRACTOR'S OR LANDOWNER'S CERTIFICATION: This water well was 1 constructed, (2) reconstructed, or (3) plugged under my jurisdiction and was completed on (mo/day/year) 8-10-92 and this record is true to the best of my knowledge and belief. Kansas Water Well Contractor's License No. 165 This Water Well Record was completed on (mo/day/yr) 8.12.92 under the business name of Maruhn Well Drilling by (signature) Lesly Maruhn

INSTRUCTIONS: Use typewriter or ball point pen. PLEASE PRESS FIRMLY and PRINT clearly. Please fill in blanks, underline or circle the correct answers. Send top three copies to Kansas Department of Health and Environment, Bureau of Water, Topeka, Kansas 66620-7320. Telephone: 913-296-5545. Send one to WATER WELL OWNER and retain one for your records.