

1 LOCATION OF WATER WELL: County: **SMITH** Fraction: **NE 1/4 NE 1/4 NW 1/4** Section Number: **20** Township Number: **T 3** Range Number: **R 11** E/D: **10**

Distance and direction from nearest town or city street address of well if located within city?

1 1/2 S 1 1/2 W Lebanon KS

2 WATER WELL OWNER:


RR#, St. Address, Box # :

Board of Agriculture, Division of Water Resources

City, State, ZIP Code :

Application Number:

3 LOCATE WELL'S LOCATION WITH AN "X" IN SECTION BOX:

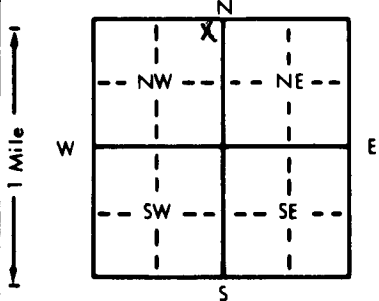

4 DEPTH OF COMPLETED WELL: **115** ft. ELEVATION:

Depth(s) Groundwater Encountered 1. **27** ft. 2. ft. 3. ft.
 WELL'S STATIC WATER LEVEL **27** ft. below land surface measured on mo/day/yr
 Pump test data: Well water was **UNKNOWN** ft. after **2-26-90** hours pumping gpm
 Est. Yield **100** gpm: Well water was ft. after **1** hours pumping **50** gpm
 Bore Hole Diameter . . . **8** in. to . . . **115** ft., and in. to ft.
 WELL WATER TO BE USED AS:
 Domestic 3 Feedlot 6 Oil field water supply 9 Dewatering 12 Other (Specify below)
 2 Irrigation 4 Industrial 7 Lawn and garden only 10 Monitoring well

Was a chemical/bacteriological sample submitted to Department? Yes No ; If yes, mo/day/yr sample was sub-

Water Well Disinfected? Yes No

5 TYPE OF BLANK CASING USED:

- 1 Steel 3 RMP (SR)
- 2 PVC 4 ABS
- 5 Wrought iron 8 Concrete tile CASING JOINTS: Glued Clamped
- 6 Asbestos-Cement 9 Other (specify below) Welded
- 7 Fiberglass Threaded

Blank casing diameter . . . **5** in. to **27** ft., Dia in. to ft., Dia in. to ft.

Casing height above land surface . . . **18** in., weight **229 cft** lbs./ft. Wall thickness or gauge No. **214**

TYPE OF SCREEN OR PERFORATION MATERIAL:

- 1 Steel 3 Stainless steel 5 Fiberglass 8 RMP (SR)
- 2 Brass 4 Galvanized steel 6 Concrete tile 9 ABS
- 10 Asbestos-cement
- 11 Other (specify)
- 12 None used (open hole)

SCREEN OR PERFORATION OPENINGS ARE:

- 1 Continuous slot 3 Mill slot 5 Gauzed wrapped 8 Saw cut 11 None (open hole)
- 2 Louvered shutter 4 Key punched 6 Wire wrapped 9 Drilled holes
- 7 Torch cut 10 Other (specify)

SCREEN-PERFORATED INTERVALS: From **27** ft. to **115** ft., From ft. to ft.

GRAVEL PACK INTERVALS: From **24** ft. to **115** ft., From ft. to ft.

6 GROUT MATERIAL: 1 Neat cement 2 Cement grout 3 Bentonite 4 Other **Flow Plug**

Grout intervals: From **0** ft. to **24** ft., From ft. to ft., From ft. to ft.

What is the nearest source of possible contamination:

- 1 Septic tank 4 Lateral lines 7 Pit privy 10 Livestock pens 14 Abandoned water well
- 2 Sewer lines 5 Cess pool 8 Sewage lagoon 11 Fuel storage 15 Oil well/Gas well
- 3 Watertight sewer lines 6 Seepage pit 9 Feedyard 12 Fertilizer storage 16 Other (specify below)
- 13 Insecticide storage

Direction from well? **N**

How many feet? **50**

FROM	TO	LITHOLOGIC LOG	FROM	TO	PLUGGING INTERVALS
0	6	Top soil & clay			
6	8	Chalky clay			
8	22	Chalk rock			
22	110	Shale grey			
110	115	Shale blue			

7 CONTRACTOR'S OR LANDOWNER'S CERTIFICATION: This water well was constructed, reconstructed, or plugged under my jurisdiction and was

completed on (mo/day/year) **2-26-90** and this record is true to the best of my knowledge and belief. Kansas

Water Well Contractor's License No. **165** This Water Well Record was completed on (mo/day/yr) **3-12-90**

under the business name of **MARATHN Well Drilling** by (signature) **Loy Maubn**