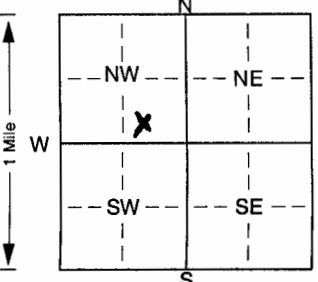


1 LOCATION OF WATER WELL: Fraction SW 1/4 SE 1/4 NW 1/4 Section Number 22 Township Number T 3 S Range Number R 12 W  
 County: Smith

Distance and direction from nearest town or city street address of well if located within city?  
1 1/2 miles South of Bellaire, KS, 1/3 mile East on Rd 165

2 WATER WELL OWNER: Ed Shellito  
 RR#, St. Address, Box #: 22012 165 ROAD Board of Agriculture, Division of Water Resources  
 City, State, ZIP Code: LEBANON, KS - 66952 Application Number:

3 LOCATE WELL'S LOCATION WITH AN "X" IN SECTION BOX:  
  
 4 DEPTH OF COMPLETED WELL: 40 ft. ELEVATION:  
 Depth(s) Groundwater Encountered: 1. 1 ft. 2. 19 ft. 3. 8/2/2006 ft.  
 WELL'S STATIC WATER LEVEL: 19 ft. below land surface measured on mo/day/yr  
 Pump test data: Well water was 5 ft. after 10 hours pumping 40 gpm  
 Est. Yield 5 gpm; Well water was 10 ft. after 40 hours pumping 40 gpm  
 Bore Hole Diameter: 10 in. to 40 ft., and 40 in. to 40 ft.  
 WELL WATER TO BE USED AS:  
 1 Domestic  3 Feedlot  6 Oil field water supply  9 Dewatering  11 Injection well  
 2 Irrigation  4 Industrial  7 Domestic (lawn & garden)  10 Monitoring well  
 Was a chemical/bacteriological sample submitted to Department? Yes No No. 0; If yes, mo/day/yr sample was submitted  
 Water Well Disinfected:  Yes  No

5 TYPE OF BLANK CASING USED:  
 1 Steel  3 RMP (SR)  6 Asbestos-Cement  9 Other (specify below)  Welded  
 2 PVC  4 ABS  7 Fiberglass  Threaded  
 Blank casing diameter: 4 1/2 in. to 30 ft., Dia 15 in. to 40 ft., Dia 15 in. to 40 ft.  
 Casing height above land surface: 15 in., weight 40 lbs./ft. Wall thickness or gauge No. Sh 40  
 TYPE OF SCREEN OR PERFORATION MATERIAL:  
 1 Steel  3 Stainless steel  5 Fiberglass  7 PVC  10 Asbestos-cement  
 2 Brass  4 Galvanized steel  6 Concrete tile  8 RMP (SR)  11 Other (specify)  
 12 None used (open hole)  
 SCREEN OR PERFORATION OPENINGS ARE:  
 1 Continuous slot  3 Mill slot  8 Saw cut  11 None (open hole)  
 2 Louvered shutter  4 Key punched  6 Wire wrapped  9 Drilled holes  
 7 Torch cut  10 Other (specify) ft.  
 SCREEN-PERFORATED INTERVALS: From 30 ft. to 40 ft., From 30 ft. to 40 ft., From 30 ft. to 40 ft.  
 GRAVEL PACK INTERVALS: From 0 ft. to 3 ft., From 20 ft. to 40 ft., From 20 ft. to 40 ft.

6 GROUT MATERIAL:  1 Neat cement  2 Cement grout  3 Bentonite  4 Other  
 Grout Intervals: From 30 ft. to 40 ft., From 30 ft. to 40 ft., From 30 ft. to 40 ft.  
 What is the nearest source of possible contamination:  
 1 Septic tank  4 Lateral lines  7 Pit privy  10 Livestock pens  14 Abandoned water well  
 2 Sewer lines  5 Cess pool  8 Sewage lagoon  11 Fuel storage  15 Oil well/Gas well  
 3 Watertight sewer lines  6 Seepage pit  9 Feedyard  12 Fertilizer storage  16 Other (specify below)  
None Known  
 Direction from well? None Known How many feet?

FROM	TO	LITHOLOGIC LOG	FROM	TO	PLUGGING INTERVALS
0	25	Topsoil into Clay			
25	30	Blue Mud			
30	40	Thin STRIPS of Blue Mud, Coarse Sand and Cobblestone			
40	41	Weathered Gray Shale			

7 CONTRACTOR'S OR LANDOWNER'S CERTIFICATION: This water well was  (1) constructed,  (2) reconstructed, or  (3) plugged under my jurisdiction and was completed on (mo/day/year) 8/2/2006 and this record is true to the best of my knowledge and belief. Kansas Water Well Contractor's Licence No. 433 This Water Well Record was completed on (mo/day/yr) 8/24/2006 under the business name of Chris Sargent Irrigation Co., INC by (signature) Randy E. Mankin