


1 LOCATION OF WATER WELL: Fraction **NW 1/4 NW 1/4 NW 1/4** Section Number **15** Township Number **T 3 S** Range Number **R 12** **EW**

County: **Smith**

Distance and direction from nearest town or city street address of well if located within city? **E side of State Hwy 182 S of RR tracks, Bellaire** Lat. **39° 47' 53"** Long. **98° 40' 18"**

2 WATER WELL OWNER: **Midway Coop Association, Inc.**  
 RR#, St. Address, Box # **P.O. Box 40** Board of Agriculture, Division of Water Resources  
 City, State, ZIP Code **Osborne, Kansas 67473** Application Number:

3 LOCATE WELL'S LOCATION WITH AN "X" IN SECTION BOX:

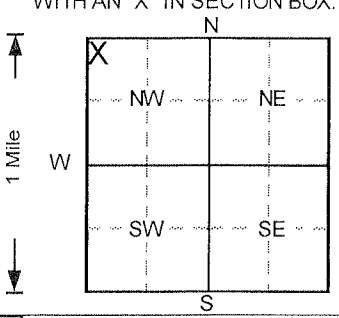

4 DEPTH OF COMPLETED WELL **37** ft. ELEVATION: **1867.79**

Depth(s) Groundwater Encountered 1. . . . . ft. 2. . . . . ft. 3. . . . . ft.

WELL'S STATIC WATER LEVEL **33.07** ft. below land surface measured on mo/day/yr **5/17/2011**

Pump test data: Well water was **NA** ft. after . . . . . hours pumping . . . . . gpm

Est. Yield **NA** gpm: Well water was . . . . . ft. after . . . . . hours pumping . . . . . gpm

Bore Hole Diameter **8** in. to **37** ft., and . . . . . in. to . . . . . ft.

WELL WATER TO BE USED AS: 5 Public water supply 8 Air conditioning 11 Injection well

1 Domestic 3 Feedlot 6 Oil field water supply 9 Dewatering 12 Other (Specify below)

2 Irrigation 4 Industrial 7 Lawn and garden only **10** Monitoring well

Was a chemical/bacteriological sample submitted to Department? Yes.....No **✓**; If yes, mo/day/yr sample was submitted Water Well Disinfected? Yes No **✓**

5 TYPE OF BLANK CASING USED: 1 Steel 3 RMP (SR) 5 Wrought iron 8 Concrete tile CASING JOINTS: Glued . . . . . Clamped . . . . .

**2** PVC 4 ABS 7 Fiberglass . . . . . Welded . . . . .

Blank casing diameter **2** in. to **22** ft., Dia . . . . . in. to . . . . . ft., Dia . . . . . in. to . . . . . ft.

Casing height above land surface **29.76** in., weight . . . . . lbs./ft. Wall thickness or gauge No. **Sch. 40**

TYPE OF SCREEN OR PERFORATION MATERIAL: **7** PVC 10 Asbestos-cement

1 Steel 3 Stainless steel 5 Fiberglass 8 RMP (SR) 11 Other (specify) . . . . .

2 Brass 4 Galvanized steel 6 Concrete tile 9 ABS 12 None used (open hole)

SCREEN OR PERFORATION OPENINGS ARE: 5 Gauzed wrapped 8 Saw cut 11 None (open hole)

1 Continuous slot **3** Mill slot 6 Wire wrapped 9 Drilled holes

2 Louvered shutter 4 Key punched 7 Torch cut 10 Other (specify) . . . . .

SCREEN-PERFORATED INTERVALS: From . . . . . **22** ft. to . . . . . **37** ft., From . . . . . ft. to . . . . . ft.

GRAVEL PACK INTERVALS: From . . . . . **20** ft. to . . . . . **37** ft., From . . . . . ft. to . . . . . ft.

6 GROUT MATERIAL: 1 Neat cement **2** Cement grout **3** Bentonite 4 Other . . . . .

Grout Intervals: From . . . . . **0** ft. to . . . . . **2** ft., From . . . . . **2** ft. to . . . . . **20** ft., From . . . . . ft. to . . . . . ft.

What is the nearest source of possible contamination: 10 Livestock pens 14 Abandoned water well

1 Septic tank 4 Lateral lines 7 Pit privy 11 Fuel storage 15 Oil well/Gas well

2 Sewer lines 5 Cess pool 8 Sewage lagoon 12 Fertilizer storage 16 Other (specify below)

3 Watertight sewer lines 6 Seepage pit 9 Feedyard 13 Insecticide storage

Direction from well? How many feet?

FROM	TO	LITHOLOGIC LOG	FROM	TO	PLUGGING INTERVALS
0	8	Clay, v. sl. silty, Lt. Brown to Yellow Brown			
8	11	Clay, silty, Brown			
11	15	Clay, silty, Dark Brown			
15	24	Clay, v. silty, Lt. Brown			
24	29	Clay, v. silty, Yellow Brown			
29	37	Clay, v. silty, Yellow Brown			
					MW8 , Tag # 0046579 , Abovegrade

7 CONTRACTOR'S OR LANDOWNER'S CERTIFICATION: This water well was **(1)** constructed, **(2)** reconstructed, or **(3)** plugged under my jurisdiction and was completed on (mo/day/year) **5/16/2011** and this record is true to the best of my knowledge and belief.

Kansas Water Well Contractor's License No. **527** This Water Well Record was completed on (mo/day/yr) **6/2/2011** under the business name of **GeoCore, Inc.** by (signature) **Dale Raby**

OFFICE USE ONLY T R EM SEC. 1/4 1/4 1/4