


1 LOCATION OF WATER WELL: County: SMITH Fraction: SW 1/4 SW 1/4 NW 1/4 Section Number: 24 Township Number: T 3 S Range Number: R 12 E

Distance and direction from nearest town or city street address of well if located within city?  
8 E 1/2 S Smith Center

2 WATER WELL OWNER: Wayne Roush  
 RR#, St. Address, Box #: RR1 Box 168  
 City, State, ZIP Code: Lebanon KS 66952  
 Board of Agriculture, Division of Water Resources  
 Application Number:

3 LOCATE WELL'S LOCATION WITH AN "X" IN SECTION BOX:

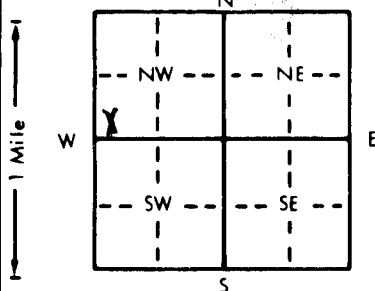

4 DEPTH OF COMPLETED WELL: 135 ft. ELEVATION:

Depth(s) Groundwater Encountered 1. 12 ft. 2. 12 ft. 3. \_\_\_\_\_ ft.  
 WELL'S STATIC WATER LEVEL: 12 ft. below land surface measured on 3-15-95 mo/day/yr  
 Pump test data: Well water was unknown ft. after 90 developed hours pumping 12 gpm  
 Est. Yield: 20 gpm: Well water was \_\_\_\_\_ ft. after \_\_\_\_\_ hours pumping \_\_\_\_\_ gpm  
 Bore Hole Diameter: 9 in. to 20 in. and 8 in. to 135 in. ft.  
 WELL WATER TO BE USED AS:  
 Domestic    3 Feedlot    6 Oil field water supply    9 Dewatering    12 Other (Specify below)  
 2 Irrigation    4 Industrial    7 Lawn and garden only    10 Monitoring well  
 Was a chemical/bacteriological sample submitted to Department? Yes \_\_\_\_\_ No X; If yes, mo/day/yr sample was submitted \_\_\_\_\_  
 Water Well Disinfected? Yes X No \_\_\_\_\_

5 TYPE OF BLANK CASING USED:  
 1 Steel    3 RMP (SR)    5 Wrought iron    8 Concrete tile    CASING JOINTS: Glued X Clamped \_\_\_\_\_  
 PVC    4 ABS    6 Asbestos-Cement    9 Other (specify below)    Welded \_\_\_\_\_  
 7 Fiberglass    Threaded \_\_\_\_\_

Blank casing diameter: 5 in. to 15 ft. Dia. \_\_\_\_\_ in. to \_\_\_\_\_ ft. Dia. \_\_\_\_\_ in. to \_\_\_\_\_ ft.  
 Casing height above land surface: 16 in. weight: 239 lbs./100 lbs./ft. Wall thickness or gauge No. 214

TYPE OF SCREEN OR PERFORATION MATERIAL:  
 1 Steel    3 Stainless steel    5 Fiberglass    8 RMP (SR)    10 Asbestos-cement  
 2 Brass    4 Galvanized steel    6 Concrete tile    9 ABS    12 None used (open hole)

SCREEN OR PERFORATION OPENINGS ARE:  
 1 Continuous slot    3 Mill slot    5 Gauzed wrapped    8 Saw cut    11 None (open hole)  
 2 Louvered shutter    4 Key punched    6 Wire wrapped    9 Drilled holes

SCREEN-PERFORATED INTERVALS: From 15 ft. to 125 ft. From \_\_\_\_\_ ft. to \_\_\_\_\_ ft.  
 GRAVEL PACK INTERVALS: From 14 ft. to 135 ft. From \_\_\_\_\_ ft. to \_\_\_\_\_ ft.

6 GROUT MATERIAL: 1 Neat cement    2 Cement grout    3 Bentonite    4 Other: hole plug  
 Grout Intervals: From 0 ft. to 14 ft. From \_\_\_\_\_ ft. to \_\_\_\_\_ ft.

What is the nearest source of possible contamination:  
 1 Septic tank    4 Lateral lines    7 Pit privy    10 Livestock pens    14 Abandoned water well  
 2 Sewer lines    5 Cess pool    8 Sewage lagoon    11 Fuel storage    15 Oil well/Gas well  
 3 Watertight sewer lines    6 Seepage pit    9 Feedyard    12 Fertilizer storage    16 Other (specify below)  
 13 Insecticide storage

Direction from well? None in sight (in pasture) How many feet? \_\_\_\_\_

| FROM |     | TO | LITHOLOGIC LOG           | FROM | TO | PLUGGING INTERVALS |
|------|-----|----|--------------------------|------|----|--------------------|
| 0    | 10  |    | Top soil + clay          |      |    |                    |
| 10   | 20  |    | Clay w/ some broken rock |      |    |                    |
| 20   | 28  |    | Broken rocks clay + sand |      |    |                    |
| 28   | 32  |    | Clay blue                |      |    |                    |
| 32   | 34  |    | Rocky chalk rock         |      |    |                    |
| 34   | 135 |    | Shale (grey)             |      |    |                    |
| 125  | 135 |    | Shale (blue)             |      |    |                    |

7 CONTRACTOR'S OR LANDOWNER'S CERTIFICATION: This water well was  constructed, (2) reconstructed, or (3) plugged under my jurisdiction and was completed on (mo/day/year) 3-15-95 and this record is true to the best of my knowledge and belief. Kansas Water Well Contractor's License No. 165 This Water Well Record was completed on (mo/day/yr) 3-15-95 9:15 PM under the business name of Maruhn Well Drilling by (signature) Leon Maruhn