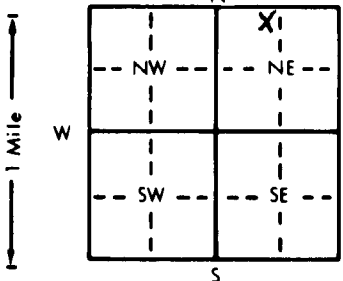


1 LOCATION OF WATER WELL:		Fraction	Section Number	Township Number	Range Number
County: <u>Smith</u>		<u>NE 1/4</u> <u>NW 1/4</u> <u>NE 1/4</u>	<u>22</u>	T <u>35</u> <u>3</u>	R <u>13 W</u> <u>EW</u>
Distance and direction from nearest town or city street address of well if located within city? <u>Northeast edge of Smith Center, KS on East Highway 36.</u>					
2 WATER WELL OWNER: <u>Country General Store</u>					
RR#, St. Address, Box #: <u>P.O. Box 328</u>					
City, State, ZIP Code: <u>Smith Center, KS 66967</u>					
Board of Agriculture, Division of Water Resources Application Number:					
3 LOCATE WELL'S LOCATION WITH AN "X" IN SECTION BOX:		4 DEPTH OF COMPLETED WELL: <u>18.0</u> ft. ELEVATION: <u>1813.8</u>			
		Depth(s) Groundwater Encountered 1. <u>16.5</u> ft. 2. <u> </u> ft. 3. <u> </u> ft.			
		WELL'S STATIC WATER LEVEL <u>16.5</u> ft. below land surface measured on <u>mo/day/yr</u> <u>1/22/97</u>			
		Pump test data: Well water was <u> </u> ft. after <u> </u> hours pumping <u> </u> gpm			
		Est. Yield <u>1/2</u> gpm: Well water was <u>Dry</u> ft. after <u>5 min</u> hours pumping <u> </u> gpm			
		Bore Hole Diameter: <u>6</u> in. to <u>18.5</u> ft. and <u> </u> in. to <u> </u> ft.			
		WELL WATER TO BE USED AS:			
		5 Public water supply 8 Air conditioning 11 Injection well			
		1 Domestic 3 Feedlot 6 Oil field water supply 9 Dewatering 12 Other (Specify below)			
		2 Irrigation 4 Industrial 7 Lawn and garden only <u>10</u> Monitoring well			
		Was a chemical/bacteriological sample submitted to Department? Yes <u> </u> No <u>X</u> ; If yes, mo/day/yr sample was submitted <u> </u>			
		Water Well Disinfected? Yes <u> </u> No <u>X</u>			
5 TYPE OF BLANK CASING USED:					
1 Steel 3 RMP (SR) 5 Wrought iron 8 Concrete tile CASING JOINTS: Glued <u> </u> Clamped <u> </u>					
<u>2</u> PVC 4 ABS 6 Asbestos-Cement 9 Other (specify below) Welded <u> </u>					
7 Fiberglass Threaded <u> </u>					
Blank casing diameter <u>2</u> in. to <u>7.8</u> ft. Dia. <u> </u> in. to <u> </u> ft. Dia. <u> </u> in. to <u> </u> ft.					
Casing height above land surface <u>2</u> in. weight <u>sch 40</u> lbs./ft. Wall thickness or gauge No. <u>sch 40</u>					
TYPE OF SCREEN OR PERFORATION MATERIAL:					
1 Steel 3 Stainless steel 5 Fiberglass 8 RMP (SR) 10 Asbestos-cement					
2 Brass 4 Galvanized steel 6 Concrete tile 9 ABS 11 Other (specify) <u> </u>					
12 None used (open hole)					
SCREEN OR PERFORATION OPENINGS ARE:					
1 Continuous slot 3 <u>M</u> slot 5 Gauzed wrapped 8 Saw cut 11 None (open hole)					
2 Louvered shutter 4 Key punched 6 Wire wrapped 9 Drilled holes					
7 Torch cut 10 Other (specify) <u> </u>					
SCREEN-PERFORATED INTERVALS: From <u>7.8</u> ft. to <u>18.0</u> ft. From <u> </u> ft. to <u> </u> ft.					
From <u> </u> ft. to <u> </u> ft. From <u> </u> ft. to <u> </u> ft.					
GRAVEL PACK INTERVALS: From <u>7.5</u> ft. to <u>18.5</u> ft. From <u> </u> ft. to <u> </u> ft.					
From <u> </u> ft. to <u> </u> ft. From <u> </u> ft. to <u> </u> ft.					
6 GROUT MATERIAL: 1 Neat cement 2 Cement grout <u>3</u> Bentonite 4 Other					
Grout intervals: From <u>1</u> ft. to <u>7.5</u> ft. From <u> </u> ft. to <u> </u> ft. From <u> </u> ft. to <u> </u> ft.					
What is the nearest source of possible contamination:					
1 Septic tank 4 Lateral lines 7 Pit privy <u>11</u> Fuel storage 14 Abandoned water well					
2 Sewer lines 5 Cess pool 8 Sewage lagoon 12 Fertilizer storage 15 Oil well/Gas well					
3 Watertight sewer lines 6 Seepage pit 9 Feedyard 13 Insecticide storage 16 Other (specify below) <u> </u>					
Direction from well? <u> </u> How many feet? <u> </u>					
FROM		TO		LITHOLOGIC LOG	
FROM		TO		PLUGGING INTERVALS	
0		4		Lean Clay, very dk brown, moist, firm	
4		10		Silty Clay, dk brown, moist, firm	
10		15		Weathered Claystone, brown, moist, firm	
15		18.5		Claystone, brown mottled grey, moist firm, with carbonates	
18.5		-		Bottom of Hole	
7 CONTRACTOR'S OR LANDOWNER'S CERTIFICATION: This water well was <u>(1)</u> constructed, (2) reconstructed, or (3) plugged under my jurisdiction and was completed on (mo/day/year) <u>1/8/97</u> and this record is true to the best of my knowledge and belief. Kansas Water Well Contractor's License No. <u>564</u> This Water Well Record was completed on (mo/day/yr) <u>1/28/97</u> under the business name of <u>E.P.S. INC.</u> by (signature) <u>William D. Wilson</u>					