


1 LOCATION OF WATER WELL: County: Smith Fraction: SE 1/4 SE 1/4 NE 1/4 Section Number: 21 Township Number: T 33 S Range Number: R 13 E (W)

Distance and direction from nearest town or city street address of well if located within city?
119 North Main, Smith Center, KS. 66967

2 WATER WELL OWNER: Gail VanderGiesen
 RR#, St. Address, Box #: 119 N. Main Board of Agriculture, Division of Water Resources
 City, State, ZIP Code: Smith Center, KS. 66967 Application Number:

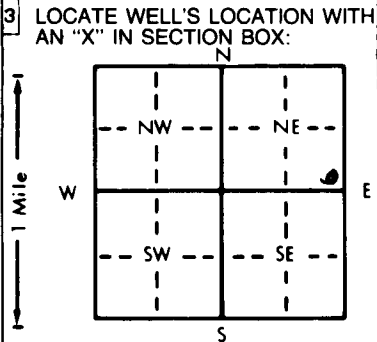

4 DEPTH OF COMPLETED WELL: 15'6" ft. ELEVATION:
 Depth(s) Groundwater Encountered: 1'10" ft. 2. _____ ft. 3. _____ ft.
 WELL'S STATIC WATER LEVEL: 7'6" ft. below land surface measured on mo/day/yr 12-11-96
 Pump test data: Well water was _____ ft. after _____ hours pumping _____ gpm
 Est. Yield _____ gpm Well water was _____ ft. after _____ hours pumping _____ gpm
 Bore Hole Diameter: 8 1/2" in. to 15'6" ft., and _____ in. to _____ ft.
 WELL WATER TO BE USED AS:
 5 Public water supply 8 Air conditioning 11 Injection well
 1 Domestic 3 Feedlot 6 Oil field water supply 9 Dewatering 12 Other (Specify below)
 2 Irrigation 4 Industrial 7 Lawn and garden only 10 Monitoring well
 Was a chemical/bacteriological sample submitted to Department? Yes _____ No X; If yes, mo/day/yr sample was submitted
 Water Well Disinfected? Yes _____ No (X)

5 TYPE OF BLANK CASING USED:
 1 Steel 3 RMP (SR) 5 Wrought iron 8 Concrete tile CASING JOINTS: Glued _____ Clamped _____
2 PVC 4 ABS 6 Asbestos-Cement 9 Other (specify below) Welded _____
 Blank casing diameter 2.375 in. to 5' ft., Dia _____ in. to _____ ft., Dia _____ in. to _____ ft. SDR 13 ft.
 Casing height above land surface: Flush Mt. in., weight _____ lbs./ft. Wall thickness or gauge No. SCH 40
 TYPE OF SCREEN OR PERFORATION MATERIAL:
 1 Steel 3 Stainless steel 5 Fiberglass 8 RMP (SR) 11 Other (specify) _____
 2 Brass 4 Galvanized steel 6 Concrete tile 9 ABS 12 None used (open hole)
 SCREEN OR PERFORATION OPENINGS ARE:
 1 Continuous slot 3 Mill slot 5 Gauzed wrapped 8 Saw cut 11 None (open hole)
 2 Louvered shutter 4 Key punched 6 Wire wrapped 9 Drilled holes
 7 Torch cut 10 Other (specify) _____
 SCREEN-PERFORATED INTERVALS: From 15' ft. to 5' ft., From _____ ft. to _____ ft.
 GRAVEL PACK INTERVALS: From 15'6" ft. to 4' ft., From _____ ft. to _____ ft.

6 GROUT MATERIAL:
 Grout Intervals: From 4' ft. to 3' ft., From 3' ft. to 0' ft., From _____ ft. to _____ ft.
 What is the nearest source of possible contamination:
 1 Septic tank 4 Lateral lines 7 Pit privy 11 Fuel storage FOUR 14 Abandoned water well
 2 Sewer lines 5 Cess pool 8 Sewage lagoon 12 Fertilizer storage 15 Oil well/Gas well
 3 Watertight sewer lines 6 Seepage pit 9 Feedyard 13 Insecticide storage 16 Other (specify below)
 Direction from well? Northwest How many feet? 95'

FROM	TO	LITHOLOGIC LOG	FROM	TO	PLUGGING INTERVALS
0	.75	Concrete			
.75	5	Dk brn silty clay, moist, soft, no odor, highly plastic.			
5	9	Lt. brn-tan silty clay w/ caliche, moist, no odor.			
9	12.50	Tan clay w/ dk gray clay mottling, mod. odor, soft.			
12.50	15'6"	Tan clay to weathered shaley clay, caliche nodules, firm, moist-dry, faint odor.			

F.H. OK'd by Don Taylor

7 CONTRACTOR'S OR LANDOWNER'S CERTIFICATION: This water well was (1) constructed (2) reconstructed, or (3) plugged under my jurisdiction and was completed on (mo/day/year) 12-11-96 and this record is true to the best of my knowledge and belief. Kansas Water Well Contractor's License No. 539 This Water Well Record was completed on (mo/day/yr) 12-16-96 under the business name of JB Environmental Drilling by (signature) James Bieker

INSTRUCTIONS: Use typewriter or ball point pen. PLEASE PRESS FIRMLY and PRINT clearly. Fill in blanks, underline or circle the correct answers. Send top three copies to Kansas Department of Health and Environment, Bureau of Water, Topeka, Kansas 66620-0001. Telephone: 913-296-5545. Send one to WATER WELL OWNER and retain one for your records.

OFFICE USE ONLY