

CORRECTION(S) TO WATER WELL RECORD (WWC-5)

(to rectify lacking or incorrect information)

County: Smith

Location listed as:

Section-Township-Range: 22-35-13W

Fraction ($\frac{1}{4}$ $\frac{1}{4}$ $\frac{1}{4}$): NE NW NE

Location changed to:

22-35-13W

NE NW NE

Other changes: Initial statements: _____

Changed to: _____

Comments: _____

verification method: Written & legal descriptions, position on plat map,
and Smith Center 1:24,000 topo. map.

initials: DRS date: 1/27/2005

submitted by: Kansas Geological Survey, Data Resources Library, 1930 Constant Ave., Lawrence, KS 66047-3726

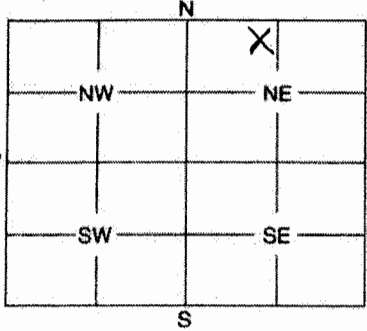
to: Kansas Dept of Health & Environment, Bureau of Water, 1000 SW Jackson, Suite 420, Topeka, KS 66612-1367.

1	LOCATION OF WATER WELL: Smith County:	Fraction NE $\frac{1}{4}$ NW $\frac{1}{4}$ NE $\frac{1}{4}$	Section Number 22	Township Number 35	Range Number 13	E/W
---	--	--	-----------------------------	------------------------------	---------------------------	-----

Distance and direction from nearest town or city street address of well if located within city?

NE Edge of Smith Center on East Hwy 36

2	WATER WELL OWNER: Country General Store (Wheelers) RR #, St. Address, Box #: P.O. Box 328 City, State, ZIP Code : Smith Center, Ks 66967		Board of Agriculture, Division of Water Resources Application Number:
---	--	--	--

3	MARK WELL'S LOCATION WITH AN "X" IN SECTION BOX: 	4	DEPTH OF WELL20..... ft. WELL'S STATIC WATER LEVEL ..18.34... ft. WELL WAS USED AS: 1 Domestic 2 Irrigation 3 Feedlot 4 Industrial 5 Public Water Supply 6 Oil Field Water Supply 7 Domestic (Lawn & Garden) 8 Air Conditioning 9 Dewatering 10 Monitoring Well 11 Injection Well 12 Other Was a chemical / bacteriological sample submitted to Department? Yes NoX..... If yes, mo/day/yr sample was submitted Water Well Disinfected: Yes NoX.....
---	--	---	---

5	TYPE OF BLANK CASING USED: 1 Steel 2 PVC 3 RMP (SR) 4 ABS 5 Wrought 6 Asbestos-Cement 7 Fiberglass 8 Concrete Tile 9 Other (Specify below) Blank casing diameter2..... in. Was casing pulled? YesX..... No If yes, how much20'..... Casing height above or below land surface in.
---	--

6	GROUT PLUG MATERIAL: 1 Neat cement 2 Cement grout 3 Bentonite 4 OtherSurface silts and clays..... Grout Plug Intervals: From20..... ft. to3..... ft., From3..... ft. to0..... ft., From to ft. What is the nearest source of possible contamination: 1 Septic tank 2 Sewer lines 3 Watertight sewer lines 4 Lateral lines 5 Cess pool 6 Seepage pit 7 Pit privy 8 Sewage lagoon 9 Feedyard 10 Livestock pens 11 Fuel storage 12 Fertilizer storage 13 Insecticide storage 14 Abandoned water well 15 Oil well/Gas well 16 Other (specify below) Direction from well? How many feet?
---	---

FROM	TO	PLUGGING MATERIALS
0	3	Surface Silt and Clays
20	3	Bentonite

RECEIVED
NOV 08 2004
BUREAU OF WATER

7	CONTRACTOR'S OF LANDOWNER'S CERTIFICATION: This water well was plugged under my jurisdiction and was completed on (mo/day/year)08/24/05..... and this record is true to the best of my knowledge and belief. Kansas Water Well Contractor's License No.585..... This Water Well Record was completed on (mo/day/year)10/27/04..... under the business name of Associated Environmental, Inc. by (signature)Darin Duncan.....
---	--

INSTRUCTIONS: Use typewriter or ball point pen. Please press firmly and print clearly. Please fill in blanks, underline or circle the correct answers. Send top three copies to Kansas Department of Health and Environment, Bureau of Water, Geology Section, 1000 SW Jackson St., Ste. 420, Topeka, Kansas 66612-1367. Telephone: 785/296-5522. Send one to Water Well Owner and retain one for your records.