

WATER WELL RECORD Form WWC-5 KSA 82a-1212


1 LOCATION OF WATER WELL: County: Smith Fraction NW 1/4 SW 1/4 SW 1/4 Section Number 22 Township Number T 3 S Range Number R 13 E/W

Distance and direction from nearest town or city street address of well if located within city?

Grant & Francis Streets, Smith Center

2 WATER WELL OWNER: Smith County Highway Dept. RR#, St. Address, Box #: 218 S. Grant Street City, State, ZIP Code: Smith Center, KS 66967 Board of Agriculture, Division of Water Resources Application Number:

3 LOCATE WELL'S LOCATION WITH AN "X" IN SECTION BOX:

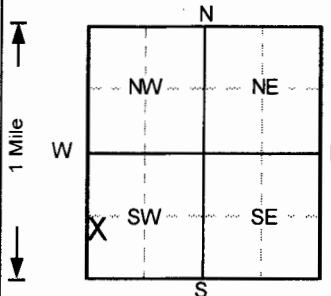

4 DEPTH OF COMPLETED WELL: 23 ft. ELEVATION: Depth(s) Groundwater Encountered: 1. ft. 2. ft. 3. ft. WELL'S STATIC WATER LEVEL: ft. below land surface measured on mo/day/yr Pump test data: Well water was NA ft. after hours pumping gpm Est. Yield NA gpm: Well water was ft. after hours pumping gpm Bore Hole Diameter: 5 in. to 23 ft., and in. to ft. WELL WATER TO BE USED AS: 5 Public water supply 8 Air conditioning 11 Injection well 1 Domestic 3 Feedlot 6 Oil field water supply 9 Dewatering 12 Other (Specify below) 2 Irrigation 4 Industrial 7 Lawn and garden only 10 Monitoring well Was a chemical/bacteriological sample submitted to Department? Yes No; If yes, mo/day/yr sample was submitted Water Well Disinfected? Yes No

5 TYPE OF BLANK CASING USED: 1 Steel 3 RMP (SR) 5 Wrought iron 8 Concrete tile CASING JOINTS: Glued Clamped 2 PVC 4 ABS 6 Asbestos-Cement 9 Other (specify below) Welded 7 Fiberglass Threaded

Blank casing diameter: 0.75 in. to 18 ft., Dia in. to ft., Dia in. to ft. Casing height above land surface: 0 in., weight lbs./ft. Wall thickness or gauge No. Sch. 40

TYPE OF SCREEN OR PERFORATION MATERIAL: 1 Steel 3 Stainless steel 5 Fiberglass 7 PVC 10 Asbestos-cement 2 Brass 4 Galvanized steel 6 Concrete tile 8 RMP (SR) 11 Other (specify) 12 None used (open hole)

SCREEN OR PERFORATION OPENINGS ARE: 1 Continuous slot 3 Mill slot 5 Gauzed wrapped 8 Saw cut 11 None (open hole) 2 Louvered shutter 4 Key punched 6 Wire wrapped 9 Drilled holes 7 Torch cut 10 Other (specify)

SCREEN-PERFORATED INTERVALS: From 18 ft to 23 ft, From ft to ft, From ft to ft, From ft to ft GRAVEL PACK INTERVALS: From 16 ft to 23 ft, From ft to ft, From ft to ft, From ft to ft

6 GROUT MATERIAL: 1 Neat cement 2 Cement grout 3 Bentonite 4 Other Grout Intervals: From 0 ft to 1 ft, From 1 ft to 16 ft, From ft to ft

What is the nearest source of possible contamination: 1 Septic tank 4 Lateral lines 7 Pit privy 10 Livestock pens 14 Abandoned water well 2 Sewer lines 5 Cess pool 8 Sewage lagoon 11 Fuel storage 15 Oil well/Gas well 3 Watertight sewer lines 6 Seepage pit 9 Feedyard 12 Fertilizer storage 16 Other (specify below) 13 Insecticide storage

Direction from well? How many feet?

Table with columns: FROM, TO, LITHOLOGIC LOG, FROM, TO, PLUGGING INTERVALS. Rows include 0-2 Gravel, 2-20 Clay, 20-23 Silt, and MW19S, Flushmount.

7 CONTRACTOR'S OR LANDOWNER'S CERTIFICATION: This water well was (1) constructed, (2) reconstructed, or (3) plugged under my jurisdiction and was completed on (mo/day/year) 4/2/2010 and this record is true to the best of my knowledge and belief. Kansas Water Well Contractor's License No. 527. This Water Well Record was completed on (mo/day/yr) 4/23/2010 under the business name of GeoCore, Inc. by (signature) Dale Hill

OFFICE USE ONLY

T

2

EW

SEC.

1/2

1/2

1/2