


1 LOCATION OF WATER WELL: Fraction NE NE NE Section Number 21 Township Number T 3 S Range Number 13  
 County: Smith E/N

Distance and direction from nearest town or city street address of well if located within city?  
SE corner US 36 Hwy 281 Smith Center MW-6

2 WATER WELL OWNER: Allen Mc Nerney  
 RR #, St. Address, Box #: 206 Snyder Dr Board of Agriculture, Division of Water Resources  
 City, State, ZIP Code: St George KS 66535 Application Number: \_\_\_\_\_

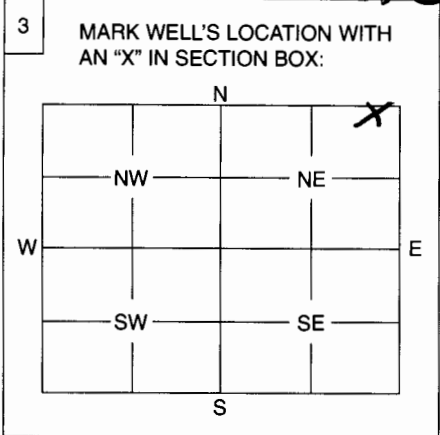

4 DEPTH OF WELL ..... 25 ft.  
 WELL'S STATIC WATER LEVEL ..... 13.3 ft.  
 WELL WAS USED AS:  
 1 Domestic                      5 Public Water Supply                      9 Dewatering  
 2 Irrigation                      6 Oil Field Water Supply                      10 Monitoring Well  
 3 Feedlot                          7 Domestic (Lawn & Garden)                      11 Injection Well  
 4 Industrial                      8 Air Conditioning                          12 Other .....

Was a chemical / bacteriological sample submitted to Department? Yes ..... No X  
 If yes, mo/day/yr sample was submitted .....

Water Well Disinfected: Yes ..... No X

5 TYPE OF BLANK CASING USED:  
 1 Steel                      3 RMP (SR)                      5 Wrought                      7 Fiberglass                      9 Other (Specify below)  
 2 PVC                      4 ABS                      6 Asbestos-Cement                      8 Concrete Tile

Blank casing diameter ..... 2 in.                      Was casing pulled? Yes X No .....                      If yes, how much ..... 3'  
 Casing height above or below land surface ..... 2 in.

6 GROUT PLUG MATERIAL: 1 Neat cement                      2 Cement grout                      3 Bentonite                      4 Other .....

Grout Plug Intervals: From ..... 25 ft. to ..... 3 ft., From ..... ft. to ..... ft., From ..... to ..... ft.

What is the nearest source of possible contamination:  
 1 Septic tank                      6 Seepage pit                      11 Fuel storage                      16 Other (specify below)  
 2 Sewer lines                      7 Pit privy                      12 Fertilizer storage  
 3 Watertight sewer lines                      8 Sewage lagoon                      13 Insecticide storage  
 4 Lateral lines                      9 Feedyard                      14 Abandoned water well  
 5 Cess pool                      10 Livestock pens                      15 Oil well/Gas well

Direction from well? ..... NW                      How many feet? ..... 80

FROM	TO	PLUGGING MATERIALS
<u>25</u>	<u>3</u>	<u>bentonite</u>
<u>3</u>	<u>0</u>	<u>soil</u>

7 CONTRACTOR'S OF LANDOWNER'S CERTIFICATION: This water well was plugged under my jurisdiction and was completed on (mo/day/year) ..... 12-7-12 ..... and this record is true to the best of my knowledge and belief. Kansas Water Well Contractor's License No. 12-142 under the business name of Solstice Co This Water Well Record was completed on (mo/day/year) .....  
 by (signature) ..... [Signature]

INSTRUCTIONS: Use typewriter or ball point pen. Please press firmly and print clearly. Please fill in blanks, underline or circle the correct answers. Send top three copies to Kansas Department of Health and Environment, Bureau of Water, Geology Section, 1000 SW Jackson St., Ste. 420, Topeka, Kansas 66612-1367. Telephone: 785/296-5522. Send one to Water Well Owner and retain one for your records.