


US HWY 36

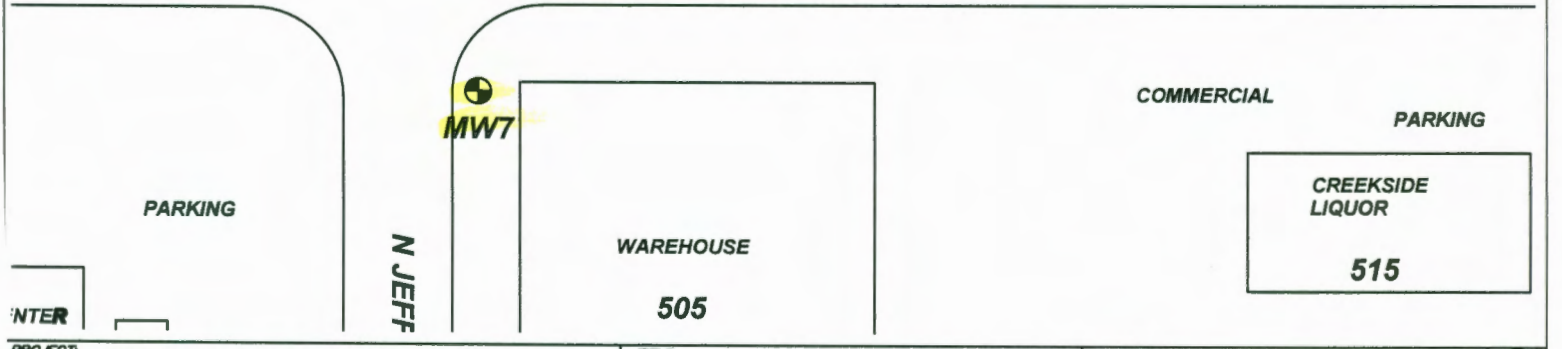

PROJECT: **TRINITY AG, LLC**

ADDRESS: **616 E. HWY 36**

LOCATION: **SMITH CENTER, KS**

DRAWN BY: **C. ROE** DATE: **4/15/20**

REVISED BY: **B. STALNAKER** DATE: **9/11/20**

AEI JOB #: **TM251** KDHE JOB #: **U6-092-15171**

TITLE:

**ASSOCIATED ENVIRONMENTAL INC.**

LEGEND:

= FORMER USTS AND PUMP ISLAND

= MONITORING WELL

= SUBJECT PROPERTY

SCALE: **1" = 50'**

NOTES: