

WATER WELL RECORD Form WWC-5

Original Record Correction Change in Well Use


Division of Water Resources App. No.

Well ID

MW11

1 LOCATION OF WATER WELL: County: SMITH Fraction SW 1/4 SW 1/4 SE 1/4 SE 1/4 Section Number 15 Township Number T 03 S Range Number R 13 E W

2 WELL OWNER: Last Name: Business: KDHE Address: 1000 SW JACKSON ST City: TOPEKA State: KS ZIP: 66612 Street or Rural Address where well is located: 616 E. HWY 36, SMITH CENTER, KS

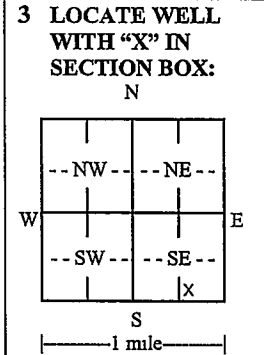

4 DEPTH OF COMPLETED WELL: 30 ft. Depth(s) Groundwater Encountered: 1) 16 ft. 2) ... ft. 3) ... ft. or 4) Dry Well WELL'S STATIC WATER LEVEL: 20.08 ft. below land surface, measured on (mo-day-yr): 10/5/21

5 Latitude: 39.78546 Longitude: 98.78014 Horizontal Datum: WGS 84 Source for Latitude/Longitude: Land Survey Source: 1820.33 ft. Elevation: 1820.33 ft. Ground Level

7 WELL WATER TO BE USED AS: 1. Domestic: Household, Lawn & Garden, Livestock, Irrigation, Feedlot, Industrial. 5. Public Water Supply. 6. Dewatering. 7. Aquifer Recharge. 8. Monitoring: MW11. 9. Environmental Remediation. 10. Oil Field Water Supply. 11. Test Hole. 12. Geothermal. 13. Other

Was a chemical/bacteriological sample submitted to KDHE? Water well disinfected?

8 TYPE OF CASING USED: Steel PVC Other CASING JOINTS: Glued Clamped Welded Threaded Casing diameter: 2 in. to 30 ft. Diameter in. to ... ft. TYPE OF SCREEN OR PERFORATION MATERIAL: Steel Stainless Steel Fiberglass PVC Brass Galvanized Steel Concrete tile None used

9 GROUT MATERIAL: Neat cement Cement grout Bentonite Other CONCRETE U-1 Grout Intervals: From 1 ft. to 13 ft.

Nearest source of possible contamination: Septic Tank Lateral Lines Pit Privy Livestock Pens Insecticide Storage Sewer Lines Cess Pool Sewage Lagoon Fuel Storage Abandoned Water Well Watertight Sewer Lines Seepage Pit Feedyard Fertilizer Storage Oil Well/Gas Well Other (Specify) No active USTs, fertilizer storage, or other possible contamination sources known w/in 500'

Table with columns: 10 FROM, TO, LITHOLOGIC LOG, FROM, TO, LITHO. LOG (cont.) or PLUGGING INTERVALS. Rows: 0-1 TOPSOIL, 1-30 Silty Clay (CL)

11 CONTRACTOR'S OR LANDOWNER'S CERTIFICATION: This water well was constructed, reconstructed, or plugged under my jurisdiction and was completed on (mo-day-year) 9/7/21 and this record is true to the best of my knowledge and belief. Kansas Water Well Contractor's License No. 585 This Water Well Record was completed on (mo-day-year) 10/1/21 under the business name of ASSOCIATED ENVIRONMENTAL, INC. Signature

SMITH CENTER  
NO 1 LLC

INDUSTRIAL

NORTH CENTRAL KANSAS  
GRAIN LLC

FORMER  
STORAGE

Soils spread  
during LSA

FORMER  
GAR

HT & ROSE  
S  
FIAL

GAR

HT & ROSE  
S

MW5  
FORMER  
BLDG

MW10

CRAWL  
SPACE

410

MW4

MW1

MW6

MW11

PARKING

NTIAL

MW2

Soils spread  
during LSA  
Addendum #1

US HWY 36

MW8

MW9

NDY

PARKING

MW7

N JEFF

WAREHOUSE

505

CHARLES & ROE  
BECKMAN

COMMERCIAL

PARKING

CREEKSIDE  
LIQUOR

515

CREEKSIDE LIQUOR

NTER

PROJECT: TRINITY AG, LLC

ADDRESS: 616 E. HWY 36

LOCATION: SMITH CENTER, KS

DRAWN BY: C. ROE DATE: 4/15/20

REVISED BY: C. ROE DATE: 9/10/21

AEI JOB #: TM251 KOHE JOB #: U6-092-15171

TITLE:

FIGURE 2.3  
AREA BASE MAP  
CLOSE-UP



ASSOCIATED  
ENVIRONMENTAL  
INC.

LEGEND:

= FORMER USTS AND PUMP ISLAND


= MONITORING WELL

= SUBJECT PROPERTY

= PARCEL BOUNDARY



SCALE: 1" = 50'

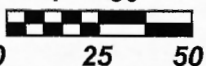

NOTES:

RECEIVED

NOV 29 2021

BUREAU OF WATER