

Form WWC-5

Division of Water
Resources App. No.

Well ID

MW13

[illegible]

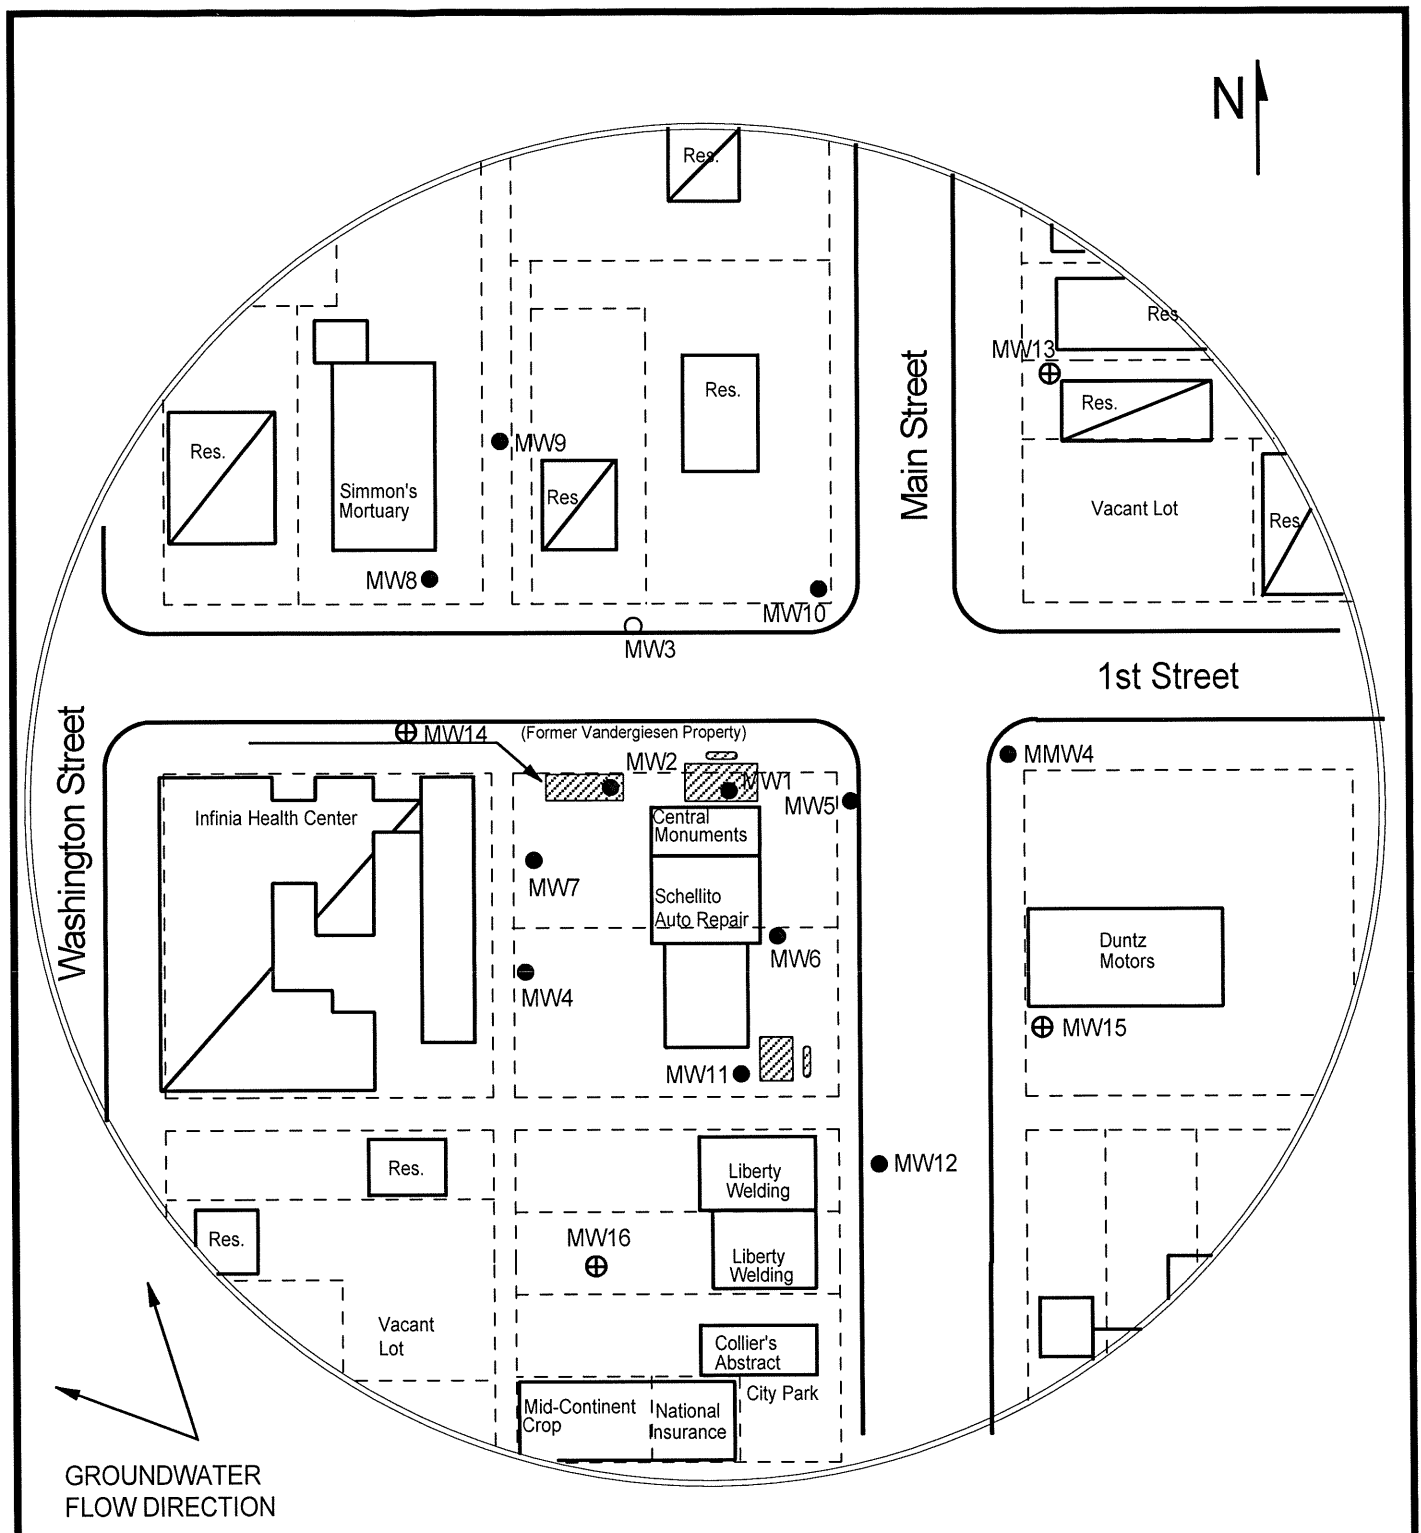


FIGURE 1 - 350 FT RADIUS AREA BASE MAP



1311 E. 25th St., Suite B (785) 841-4707 (office)
Lawrence, KS 66046 (785) 865-4282 (fax)

PROJECT:

Vandergiesen Printing
119 N. Main
Smith Center, KS
KDHE ID: U6-092-10487
Date: 3/6-7/23

0 100 ft

LEGEND

- Approximate Size/Location of Former UST Basin/Pump Island
- Approximate Location of Property Lines
- Building with Basement
- Monitoring Well
- New Monitoring Well (Installed 3/6-7/23)