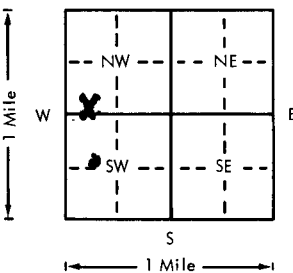
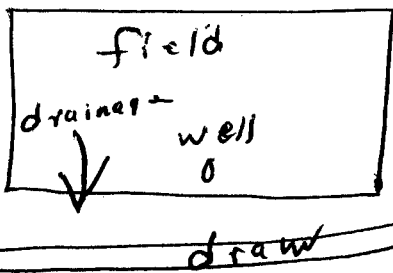


USE TYPEWRITER OR BALL  
POINT PEN-PRESS FIRMLY,  
PRINT CLEARLY.

WATER WELL RECORD  
KSA 82a-1201-1215

Kansas Department of Health and  
Environment-Division of Environment  
(Water well Contractors)  
Topeka, Kansas 66620

1. Location of well:		County <b>SMITH</b>	Fraction <b>SE 1/4 SW 1/4 NW 1/4</b>	Section number <b>17</b>	Township number <b>3</b>	Range number <b>13</b>	EW <b>E</b>
2. Distance and direction from nearest town or city:		3. Owner of well:		Steve Peterson			
Street address of well location if in city:		R.R. or street:		513 N Lincoln			
City, state, zip code:		SMITH center KS		City, state, zip code: SMITH center KS			
4. Locate with "X" in section below:		Sketch map:		6. Bore hole dia. <b>8</b> in. Completion date <b>6-13-79</b> Well depth <b>70</b> ft.			
				7. <input checked="" type="checkbox"/> Cable tool <input checked="" type="checkbox"/> Rotary <input type="checkbox"/> Driven <input type="checkbox"/> Dug <input type="checkbox"/> Hollow rod <input type="checkbox"/> Jetted <input type="checkbox"/> Bored <input type="checkbox"/> Reverse rotary			
5. Type and color of material		From		To		8. Use: <input type="checkbox"/> Domestic <input type="checkbox"/> Public supply <input type="checkbox"/> Industry <input type="checkbox"/> Irrigation <input type="checkbox"/> Air conditioning <input checked="" type="checkbox"/> Stock <input type="checkbox"/> Lawn <input type="checkbox"/> Oil field water <input type="checkbox"/> Other	
Top soil & clay's		0		35		9. Casing: Material <b>prc</b> Height: <b>9</b> or below Threaded <input type="checkbox"/> Welded <input type="checkbox"/> Surface <b>14</b> in. RMP <input type="checkbox"/> PVC <input type="checkbox"/> Weight <input type="checkbox"/> lbs./ft.	
broken rocks, sand, & clay		35		58		Dia. <b>5</b> in. to <b>20</b> ft. depth Wall Thickness: inches or Dia. <input type="checkbox"/> in. to <input type="checkbox"/> ft. depth gage No. <b>265</b>	
shale		58		70		10. Screen: Manufacturer's name <b>Jet Stream</b> Type <b>slotted prc</b> Dia. <b>5</b> Slot/gauze <b>0030</b> Length <b>30</b> Set between <b>40</b> ft. and <b>60</b> ft. ft. and <input type="checkbox"/> ft.	
						Gravel pack? <b>yes</b> Size range of material <b>fine</b>	
						11. Static water level: <input type="checkbox"/> mo./day/yr. <b>27</b> ft. below land surface Date <b>6-13-79</b>	
						12. Pumping level below land surfaces: <b>air developed</b> ft. after <b>1</b> hrs. pumping <b>12</b> g.p.m. ft. after <input type="checkbox"/> hrs. pumping <input type="checkbox"/> g.p.m. Estimated maximum yield <b>20</b> g.p.m.	
						13. Water sample submitted: <input type="checkbox"/> mo./day/yr. Yes <input checked="" type="checkbox"/> No <input type="checkbox"/> Date <input type="checkbox"/>	
						14. Well head completion: Pitless adapter <b>14</b> inches above grade	
						15. Well grouted? <b>yes</b> With: <input checked="" type="checkbox"/> Neat cement <input checked="" type="checkbox"/> Bentonite <input type="checkbox"/> Concrete Depth: From <b>0</b> ft. to <b>14</b> ft.	
						16. Nearest source of possible contamination: ft. <b>200</b> Direction <b>S</b> Type <b>draw</b> Well disinfected upon completion? <input checked="" type="checkbox"/> Yes <input type="checkbox"/> No	
						17. Pump: <input checked="" type="checkbox"/> Not installed Manufacturer's name <input type="checkbox"/> Model number <input type="checkbox"/> HP <input type="checkbox"/> Volts <input type="checkbox"/> Length of drop pipe <input type="checkbox"/> ft. capacity <input type="checkbox"/> g.p.m. Type: <input type="checkbox"/> Submersible <input type="checkbox"/> Turbine <input type="checkbox"/> Jet <input type="checkbox"/> Reciprocating <input type="checkbox"/> Centrifugal <input type="checkbox"/> Other	
						(Use a second sheet if needed)	
18. Elevation:		19. Remarks:		20. Water well contractor's certification: This well was drilled under my jurisdiction and this report is true to the best of my knowledge and belief. <b>MARUHN well Drilling</b> Business name <b>Redcloud NE</b> License No. <b>165</b> Address <b>Levy Marm</b> Date <b>6-23-79</b> Signed <b>Levy Marm</b> Authorized representative			
Topography: <input type="checkbox"/> Hill <input type="checkbox"/> Slope <input checked="" type="checkbox"/> Upland <input type="checkbox"/> Valley							