


USE TYPEWRITER OR BALL POINT PEN-PRESS FIRMLY, PRINT CLEARLY.

WATER WELL RECORD
KSA 82a-1201-1215

Kansas Department of Health and Environment-Division of Environment (Water well Contractors) Topeka, Kansas 66620

1. Location of well: County Smith Fraction NE 1/4 NW 1/4 NW 1/4 Section number 30 Township number T 3 S R 13 EW W

2. Distance and direction from nearest town or city: 3 miles west of Smith Center, KS
3. Owner of well: BRAD TIMMONS
R.R. or street: RT 1
City, state, zip code: SMITH CENTER, KS. 66967

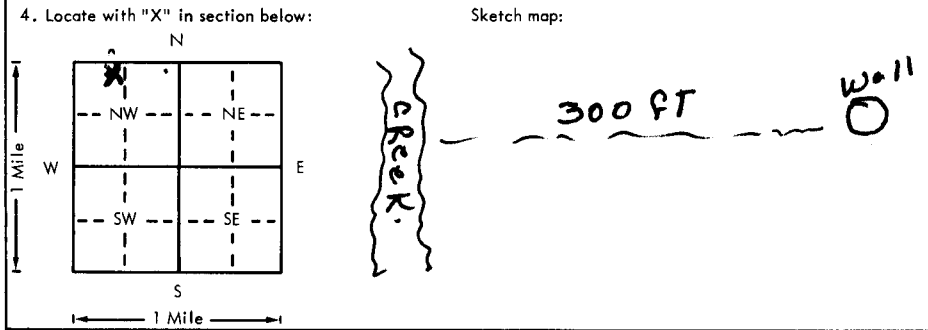

6. Bore hole dia. 9 in. Completion date 4/26/79
Well depth 53 ft.

7. Cable tool Rotary Driven Dug
 Hollow rod Jetted Bored Reverse rotary

8. Use: Domestic Public supply Industry
 Irrigation Air conditioning Stock
 Lawn Oil field water Other

9. Casing: Material PLASTIC Height: Above or below
Threaded Welded Surface 24 in.
RMP PVC Weight lbs./ft.
Dia. 6 in. to 53 ft. depth Wall Thickness: inches or
Dia. in. to ft. depth gage No. 60 PSI

5. Type and color of material	From	To
CLAY	0	22
FINE SAND	22	30
Mud & SAND	30	53
SHALE	53	-

10. Screen: Manufacturer's name CAPTAIN TACO
Type PLASTIC Dia. 6"
Slot/gauze 1/4" Length 10'
Set between 43 ft. and 53 ft.
Gravel pack? Size range of material 1/4-5/8"

11. Static water level: 22 ft. below land surface Date 4/26/79

12. Pumping level below land surfaces: NOT DONE
____ ft. after ____ hrs. pumping ____ g.p.m.
____ ft. after ____ hrs. pumping ____ g.p.m.
Estimated maximum yield ____ g.p.m.

13. Water sample submitted: ____ mo./day/yr.
Yes No Date ____

14. Well head completion: NO
____ Pitless adapter ____ Inches above grade

15. Well grouted? YES
With: Neat cement Bentonite Concrete
Depth: From 0 ft. to 10 ft.

16. Nearest source of possible contamination:
ft. 300 Direction WEST Type CREEK
Well disinfected upon completion? Yes No

17. Pump: Not installed
Manufacturer's name ____
Model number ____ HP ____ Volts ____
Length of drop pipe ____ ft. capacity ____ g.p.m.
Type:
 Submersible Turbine
 Jet Reciprocating
 Centrifugal Other

18. Elevation:
Topography:
 Hill
 Slope
 Upland
 Valley

19. Remarks:
CUSTOMER TO INSTALL CEMENT SLAB AT GROUND LEVEL

20. Water well contractor's certification:
This well was drilled under my jurisdiction and this report is true to the best of my knowledge and belief.
Business name D.E.L. DRILLING CO License No. 303
Address 368 Hill City, KS. 67142
Signed Alan L. Person Date 5/24/79
Authorized representative

T 3 130 W 30 NE NW 1/4 1/4 Sec