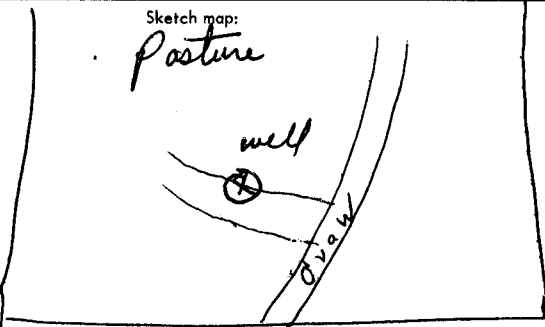
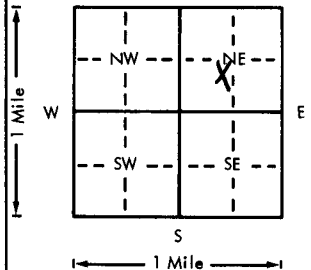


USE TYPEWRITER OR BALL POINT PEN—PRESS FIRMLY, PRINT CLEARLY.

WATER WELL RECORD
KSA 82a-1201-1215

Kansas Department of Health and Environment—Division of Environment
(Water well Contractors)
Topeka, Kansas 66620

1. Location of well:		County SMITH	Fraction NE 1/4 SW 1/4 NE 1/4	Section number 36	Township number T 3 S R	Range number 13 E (W)
2. Distance and direction from nearest town or city: Street address of well location if in city:		1 S 2 3/4 E of Smith Center		3. Owner of well: Glen Eller R.R. or street: City, state, zip code: SMITH Center		
4. Locate with "X" in section below:		Sketch map: 			6. Bore hole dia. 8 in. Completion date 7-6-77 Well depth 35 ft.	
		7. <input checked="" type="checkbox"/> Cable tool <input checked="" type="checkbox"/> Rotary <input type="checkbox"/> Driven <input type="checkbox"/> Dug <input type="checkbox"/> Hollow rod <input type="checkbox"/> Jetted <input type="checkbox"/> Bored <input type="checkbox"/> Reverse rotary		8. Use: <input type="checkbox"/> Domestic <input type="checkbox"/> Public supply <input type="checkbox"/> Industry <input type="checkbox"/> Irrigation <input type="checkbox"/> Air conditioning <input checked="" type="checkbox"/> Stock <input type="checkbox"/> Lawn <input type="checkbox"/> Oil field water <input type="checkbox"/> Other		
		9. Casing: Material PVC Height: <input checked="" type="checkbox"/> Above <input type="checkbox"/> below Threaded <input type="checkbox"/> Welded <input type="checkbox"/> Surface 24 in. RMP <input type="checkbox"/> PVC <input type="checkbox"/> Weight _____ lbs./ft. Dia. 5 in. to 35 ft. depth Wall Thickness inches or Dia. _____ in. to _____ ft. depth gage No. .180		10. Screen: Manufacturer's name Crown Line Type Slotted PVC Dia. 5 Slot/gauge .0030 Length 15' Set between 20 ft. and 35 ft. _____ ft. and _____ ft. Gravel pack? <input checked="" type="checkbox"/> yes Size range of material fine-1/4		
5. Type and color of material		From	To	11. Static water level: _____ mo./day/yr. 18 ft. below land surface Date 7-6-77		
Top Soil & clay		0	20	12. Pumping level below land surfaces: 20 ft. after 1 hrs. pumping 6 g.p.m. _____ ft. after _____ hrs. pumping _____ g.p.m. Estimated maximum yield 6 g.p.m.		
clay w/ some broken rocks		20	30	13. Water sample submitted: _____ mo./day/yr. Yes <input checked="" type="checkbox"/> No <input type="checkbox"/> Date _____		
Shale		30	35	14. Well head completion: <input type="checkbox"/> Pitless adapter 24 inches above grade		
				15. Well grouted? yes With: <input type="checkbox"/> Neat cement <input checked="" type="checkbox"/> Bentonite <input type="checkbox"/> Concrete Depth: From 0 ft. to 15 ft.		
				16. Nearest source of possible contamination: none known ft. _____ Direction _____ Type _____ Well disinfected upon completion? <input checked="" type="checkbox"/> Yes <input type="checkbox"/> No		
				17. Pump: <input checked="" type="checkbox"/> Not installed Manufacturer's name _____ HP _____ Volts _____ Length of drop pipe _____ ft. capacity _____ g.p.m. Type: <input type="checkbox"/> Submersible <input type="checkbox"/> Turbine <input type="checkbox"/> Jet <input type="checkbox"/> Reciprocating <input type="checkbox"/> Centrifugal <input type="checkbox"/> Other		
				20. Water well contractor's certification: This well was drilled under my jurisdiction and this report is true to the best of my knowledge and belief. MARUHN well Drilling 165 Business name _____ License No. _____ Address Red Cloud Ne Signed Larry Maruhn Date 7-10-77 Authorized representative		
18. Elevation:		19. Remarks:				
Topography: <input type="checkbox"/> Hill <input type="checkbox"/> Slope <input type="checkbox"/> Upland <input checked="" type="checkbox"/> Valley						

(Use a second sheet if needed)

T
R
E
S
E
C
1
3
6
NE
SW
NE
1/4
1/4
1/4
1/4