


1] LOCATION OF WATER WELL: County: Smith Fraction: SE 1/4 SE 1/4 NE 1/4 Section Number: 21 Township Number: T 3 S Range Number: R 13 EW

Distance and direction from nearest town or city street address of well if located within city? in town

2] WATER WELL OWNER: Musser Oil RR#, St. Address, Box #: 102 N. Main City, State, ZIP Code: Smith Center, Ks. Board of Agriculture, Division of Water Resources Application Number: MW4

3] LOCATE WELL'S LOCATION WITH AN "X" IN SECTION BOX:

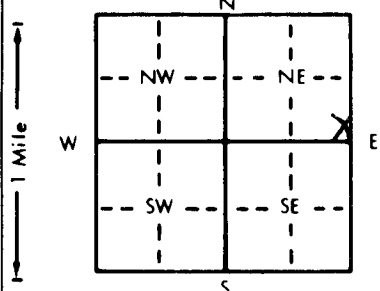

4] DEPTH OF COMPLETED WELL: 17.0 ft. ELEVATION:

Depth(s) Groundwater Encountered: 1. ft. 2. ft. 3. ft.
 WELL'S STATIC WATER LEVEL: 9.72 ft. below land surface measured on mo/day/yr
 Pump test data: Well water was ft. after hours pumping gpm
 Est. Yield gpm: Well water was ft. after hours pumping gpm
 Bore Hole Diameter in. to ft., and in. to ft.
 WELL WATER TO BE USED AS:
 1 Domestic 3 Feedlot 6 Oil field water supply 9 Dewatering 12 Other (Specify below)
 2 Irrigation 4 Industrial 7 Lawn and garden only 10 Monitoring well
 Was a chemical/bacteriological sample submitted to Department? Yes No; If yes, mo/day/yr sample was submitted
 Water Well Disinfected? Yes No

5] TYPE OF BLANK CASING USED: 1 Steel 3 RMP (SR) 5 Wrought iron 8 Concrete tile CASING JOINTS: Glued Clamped
2 PVC 4 ABS 6 Asbestos-Cement 9 Other (specify below) Welded
 7 Fiberglass Threaded

Blank casing diameter: 2 in. to 7.0 ft., Dia in. to ft., Dia in. to ft.
 Casing height above land surface: 0 in., weight lbs./ft. Wall thickness or gauge No.

TYPE OF SCREEN OR PERFORATION MATERIAL: 7 PVC 10 Asbestos-cement
 1 Steel 3 Stainless steel 5 Fiberglass 8 RMP (SR) 11 Other (specify)
 2 Brass 4 Galvanized steel 6 Concrete tile 9 ABS 12 None used (open hole)

SCREEN OR PERFORATION OPENINGS ARE:
 1 Continuous slot 3 Mill slot 5 Gauzed wrapped 8 Saw cut 11 None (open hole)
 2 Louvered shutter 4 Key punched 6 Wire wrapped 9 Drilled holes
 7 Torch cut 10 Other (specify)

SCREEN-PERFORATED INTERVALS: From 7.0 ft. to 17.0 ft., From ft. to ft.
 From ft. to ft., From ft. to ft.
 GRAVEL PACK INTERVALS: From 0.0 ft. to 17.0 ft., From ft. to ft.
 From ft. to ft., From ft. to ft.

6] GROUT MATERIAL: 1 Neat cement 2 Cement grout 3 Bentonite 4 Other
 Grout Intervals: From 0 ft. to 1.0 ft., From 1.0 ft. to 4.0 ft., From 4.0 ft. to 6.0 ft.

What is the nearest source of possible contamination:
 1 Septic tank 4 Lateral lines 7 Pit privy 10 Livestock pens 14 Abandoned water well
 2 Sewer lines 5 Cess pool 8 Sewage lagoon 11 Fuel storage 15 Oil well/Gas well
 3 Watertight sewer lines 6 Seepage pit 9 Feedyard 12 Fertilizer storage 16 Other (specify below)
 13 Insecticide storage

Direction from well? How many feet?

FROM	TO	LITHOLOGIC LOG	FROM	TO	PLUGGING INTERVALS
<u>0</u>	<u>2.0</u>	<u>Top soil clay, dark brown</u>			
<u>2.0</u>	<u>10.0</u>	<u>clay light brown</u>			
<u>10.0</u>	<u>17.0</u>	<u>shale, light brown</u>			

7] CONTRACTOR'S OR LANDOWNER'S CERTIFICATION: This water well was (1) constructed, (2) reconstructed, or (3) plugged under my jurisdiction and was completed on (mo/day/year) 3/12/94 and this record is true to the best of my knowledge and belief. Kansas Water Well Contractor's License No. 4-38 This Water Well Record was completed on (mo/day/yr) 3/11/94 under the business name of Kansas City Teesdale Inc by (signature) [Signature]