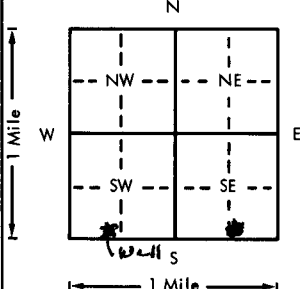


USE TYPEWRITER OR BALL POINT PEN-PRESS FIRMLY, PRINT CLEARLY.

WATER WELL RECORD
KSA 82a-1201-1215

Kansas Department of Health and Environment-Division of Environment (Water well Contractors) Topeka, Kansas 66620

1. Location of well:	County SMITH	Fraction SE 1/4 SW 1/4 SW 1/4	Section number 12	Township number T 3 S	Range number R 14
2. Distance and direction from nearest town or city: 4 miles west			3. Owner of well: Cedric Post		
Street address of well location if in city: 2 1/2 NORTH OP SMITH CENTER, KS.			R.R. or street: R. ROUTE		
4. Locate with "X" in section below: 			City, state, zip code: SMITH CENTER, KS. 66967		
5. Type and color of material			6. Bore hole dia. 9 in. Completion date 8/22/1977 Well depth 56 ft.		
			7. <input checked="" type="checkbox"/> Cable tool <input checked="" type="checkbox"/> Rotary <input type="checkbox"/> Driven <input type="checkbox"/> Dug <input type="checkbox"/> Hollow rod <input type="checkbox"/> Jetted <input type="checkbox"/> Bored <input type="checkbox"/> Reverse rotary		
			8. Use: <input type="checkbox"/> Domestic <input type="checkbox"/> Public supply <input type="checkbox"/> Industry <input type="checkbox"/> Irrigation <input type="checkbox"/> Air conditioning <input checked="" type="checkbox"/> Stock <input type="checkbox"/> Lawn <input type="checkbox"/> Oil field water <input type="checkbox"/> Other		
			9. Casing: Material PLST Height: Above or below Threaded <input type="checkbox"/> Welded gd Surface 1.8 in. RMP <input checked="" type="checkbox"/> PVC <input type="checkbox"/> Weight 10 lbs./ft. Dia. 5 in. to 4.6 ft. depth; Wall Thickness: inches or Dia. <input type="checkbox"/> in. to <input type="checkbox"/> ft. depth; gage No. 1250		
			10. Screen: Manufacturer's name JESS & Lowell Type PLASTIC Dia. 5" Slot/gauze 1/16 Length 10' Set between 5.6 ft. and 4.6 ft. Gravel pack? yes Size range of material 1/4-1/8		
			11. Static water level: 37 ft. below land surface Date 8/22/77 mp./day/yr.		
			12. Pumping level below land surfaces: NOT PUMPED ____ ft. after ____ hrs. pumping ____ g.p.m. ____ ft. after ____ hrs. pumping ____ g.p.m. Estimated maximum yield ____ g.p.m.		
			13. Water sample submitted: ____ mo./day/yr. Yes <input checked="" type="checkbox"/> No <input type="checkbox"/> Date		
			14. Well head completion: NOT DONE ____ Pitless adapter ____ Inches above grade		
			15. Well grouted? yes With: <input checked="" type="checkbox"/> Neat cement <input type="checkbox"/> Bentonite <input type="checkbox"/> Concrete Depth: From 5 ft. to 15 ft.		
			16. Nearest source of possible contamination: BARN LOT 3960 Direction NORTH Type Well disinfected upon completion? ____ Yes <input checked="" type="checkbox"/> No		
			17. Pump: <input checked="" type="checkbox"/> Not installed Manufacturer's name ____ HP ____ Volts ____ Length of drop pipe ____ ft. capacity ____ g.p.m. Type: <input type="checkbox"/> Submersible <input type="checkbox"/> Turbine <input type="checkbox"/> Jet <input type="checkbox"/> Reciprocating <input type="checkbox"/> Centrifugal <input type="checkbox"/> Other		
18. Elevation: Topography: <input type="checkbox"/> Hill <input checked="" type="checkbox"/> Slope <input type="checkbox"/> Upland <input type="checkbox"/> Valley			19. Remarks: Concrete Slab to be installed by customer at surface of ground.		
			20. Water well contractor's certification: This well was drilled under my jurisdiction and this report is true to the best of my knowledge and belief. D&L Drilling Co 303 Business name 3681 License No. SE 20510 Address HILL CITY, KS. 67642 Signed William Jones Date 8/22/77 Authorized representative		

3
 14
 W
 12
 SE 20510
 1/4 1/4 8/4
 Sec