


USE TYPEWRITER OR BALL POINT PEN-PRESS FIRMLY, PRINT CLEARLY.


WATER WELL RECORD
KSA 82a-1201-1215

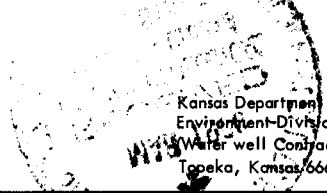

Kansas Department of Health and Environment
Division of Environment
Water Well Contractors
Topeka, Kansas 66620

Location of well: **Smith** County **Smith** Fraction **SW 1/4 SW 1/4 SW 1/4** Section number **28** Township number **T 3 S 14 R 14** Range number **14** E/W **W**

Distance and direction from nearest town or city: **1 1/2 mile SOUTH** 3. Owner of well: **Rolland Pohlman**
Street address of well location if in city: **1/2 mile SOUTH of Athol, Ks.** R.R. or street: **R.R.**
City, state, zip code: **Athol, Ks. 66932**

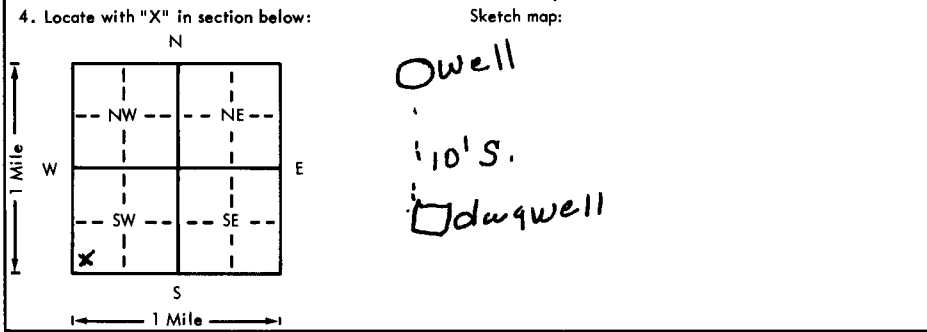

6. Bore hole dia. **9** in. Completion date **8/3/77**
Well depth **33** ft.
7. Cable tool Rotary Driven Dug
 Hollow rod Jetted Bored Reverse rotary
8. Use: Domestic Public supply Industry
 Irrigation Air conditioning Stock
 Lawn Oil field water Other
9. Casing: Material **plastic** Height: Above or below
Threaded Welded **old** Surface **18** in.
RMP PVC Weight lbs./ft.
Dia. **5** in. to **23** ft. depth Wall Thickness: inches or
Dia. in. to ft. depth gage No. **250**

5. Type and color of material	From	To
CLAY	0	15
BROKEN ROCK & SAND	15	23
Rock	23	25
CLAY	25	30
Rock & clay strips	30	32
Shale	32	33
(Use a second sheet if needed)		

10. Screen: Manufacturer's name **Jess & Lowell**
Type **PISTON** Dia. **5"**
Slot/gauze **1/16** Length **10'**
Set between **33** ft. and **23** ft.
ft. and _____ ft.
Gravel pack? **yes** Size range of material **1/4 - 3/8**
11. Static water level: _____ mo./day/yr.
20 ft. below land surface Date **8/3/77**
12. Pumping level below land surfaces: **NOT PUMPED**
_____ ft. after _____ hrs. pumping _____ g.p.m.
_____ ft. after _____ hrs. pumping _____ g.p.m.
Estimated maximum yield _____ g.p.m.
13. Water sample submitted: _____ mo./day/yr.
Yes No Date _____
14. Well head completion: **NOT DONE**
_____ Pitless adapter _____ Inches above grade
15. Well grouted? **yes**
With: Neat cement Bentonite Concrete
Depth: From **4** ft. to **14** ft.
16. Nearest source of possible contamination: **dug well**
ft. **10** Direction **south** Type **well**
Well disinfected upon completion? _____ Yes No
17. Pump: Not installed
Manufacturer's name _____
Model number _____ HP _____ Volts _____
Length of drop pipe _____ ft. capacity _____ g.p.m.
Type:
 Submersible Turbine
 Jet Reciprocating
 Centrifugal Other

18. Elevation: _____
Topography: Hill Slope Upland Valley
19. Remarks: **CEMENTS lab To be RUN by customer AT ground level.**

20. Water well contractor's certification:
This well was drilled under my jurisdiction and this report is true to the best of my knowledge and belief.
D&L Drilling Co 303
Business name **H. B. 310** License No. _____
Address **ATHOL, Ks. 66942**
Signed **Allen [Signature]** Date **10-10-77**
Authorized Representative

T 3 S 14 R 14 E 28 S 28 W 1/4 1/4 1/4