


1 LOCATION OF WATER WELL: County: Smith Fraction: SE 1/4 SE 1/4 NE 1/4 Section Number: 29 Township Number: T 23 S Range Number: R 15 E

Distance and direction from nearest town or city street address of well if located within city? SE corner of Ash and Main Kensington KS 66251

2 WATER WELL OWNER: Roger Rust RR#, St. Address, Box #: RR# 1 Box 172 A City, State, ZIP Code: Kensington KS 66251 Board of Agriculture, Division of Water Resources Application Number:

3 LOCATE WELL'S LOCATION WITH AN "X" IN SECTION BOX: 4 DEPTH OF COMPLETED WELL: 44 ft. ELEVATION: TOC = 1777.16

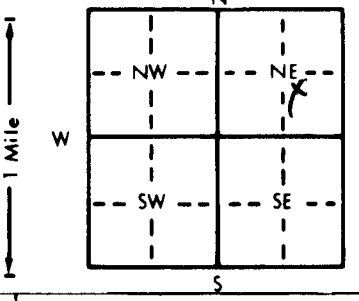

Depth(s) Groundwater Encountered: 1. ~39 ft. 2. ft. 3. ft. WELL'S STATIC WATER LEVEL: 35.89 ft. below land surface measured on mo/day/yr 7/24/96

5 TYPE OF BLANK CASING USED: 1 Steel, 3 RMP (SR), 6 Asbestos-Cement, 9 Other (specify below) CASING JOINTS: Glued, Clamped, Welded, Threaded

Blank casing diameter: 2 in. to 2.9 ft., Dia. in. to ft., Dia. in. to ft. Casing height above land surface: Flush in., weight 7 lbs./ft. Wall thickness or gauge No. 1067"

TYPE OF SCREEN OR PERFORATION MATERIAL: 1 Steel, 3 Stainless steel, 5 Fiberglass, 8 RMP (SR), 11 Other (specify), 10 Asbestos-cement

SCREEN OR PERFORATION OPENINGS ARE: 1 Continuous slot, 5 Mill slot, 6 Wire wrapped, 9 Drilled holes, 11 None (open hole)

SCREEN-PERFORATED INTERVALS: From 44 ft. to 29 ft. GRAVEL PACK INTERVALS: From 44 ft. to 27 ft.

6 GROUT MATERIAL: 1 Neat cement, 2 Cement grout, Bentonite, 4 Other Grout Intervals: From 27 ft. to 5 ft.

What is the nearest source of possible contamination: 1 Septic tank, 4 Lateral lines, 7 Pit privy, 10 Livestock pens, 14 Abandoned water well

Direction from well? East How many feet? 70

Table with columns: FROM, TO, LITHOLOGIC LOG, FROM, TO, PLUGGING INTERVALS. Row 1: 0, 40, Silty Clay w/ sand stringers, , , Row 2: 40, 47, Fine to coarse sand, ,

7 CONTRACTOR'S OR LANDOWNER'S CERTIFICATION: This water well was (1) constructed, (2) reconstructed, or (3) plugged under my jurisdiction and was completed on (mo/day/year) 7/18/96 and this record is true to the best of my knowledge and belief. Kansas Water Well Contractor's License No. 594 This Water Well Record was completed on (mo/day/yr) 8/25/96 under the business name of Coranco Inc by (signature)