


1 LOCATION OF WATER WELL: County: <b>Smith</b>	Fraction <b>NE 1/4 NW 1/4 NW 1/4</b>	Section Number <b>28</b>	Township Number <b>T 3 S</b>	Range Number <b>R 15 E</b>
---	---	-----------------------------	---------------------------------	-------------------------------

Distance and direction from nearest town or city street address of well if located within city?  
**East Highway 36, Kensington, Kansas 66951 MW11**

2 WATER WELL OWNER: **Harold Standley**  
 RR#, St. Address, Box # : **East Highway 36**  
 City, State, ZIP Code : **Kensington, Ks. 66951**  
 Board of Agriculture, Division of Water Resources  
 Application Number:

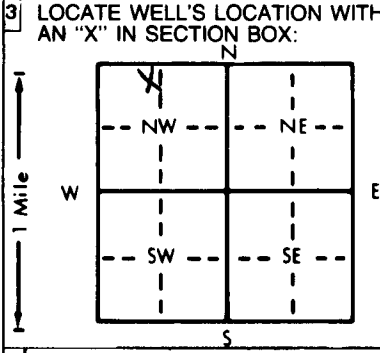

4 DEPTH OF COMPLETED WELL: **19.3** ft. ELEVATION: ..... ft.  
 Depth(s) Groundwater Encountered 1. .... **15** ft. 2. .... ft. 3. .... ft.  
 WELL'S STATIC WATER LEVEL **15.01** ft. below land surface measured on mo/day/yr **10-19-92**  
 Pump test data: Well water was ..... ft. after ..... hours pumping ..... gpm  
 Est. Yield ..... gpm: Well water was ..... ft. after ..... hours pumping ..... gpm  
 Bore Hole Diameter: **7 5/8** in. to **19.3** ft., and ..... in. to ..... ft.  
 WELL WATER TO BE USED AS:  
 5 Public water supply 8 Air conditioning 11 Injection well  
 1 Domestic 3 Feedlot 6 Oil field water supply 9 Dewatering 12 Other (Specify below)  
 2 Irrigation 4 Industrial 7 Lawn and garden only  Monitoring well  
 Was a chemical/bacteriological sample submitted to Department? Yes.....No ; If yes, mo/day/yr sample was sub-  
 mitted Water Well Disinfected? Yes No

5 TYPE OF BLANK CASING USED:  
 1 Steel 3 RMP (SR) 5 Wrought iron 8 Concrete tile CASING JOINTS: Glued ..... Clamped .....  
 PVC 4 ABS 6 Asbestos-Cement 9 Other (specify below) Welded .....  
 7 Fiberglass Threaded   
 Blank casing diameter ..... **2** in. to **9.3** ft., Dia ..... in. to ..... ft., Dia ..... in. to ..... ft.  
 Casing height above land surface ..... **0** in., weight ..... lbs./ft. Wall thickness or gauge No. **Sch. 40**  
 TYPE OF SCREEN OR PERFORATION MATERIAL:  
 1 Steel 3 Stainless steel 5 Fiberglass  PVC 10 Asbestos-cement  
 2 Brass 4 Galvanized steel 6 Concrete tile 8 RMP (SR) 11 Other (specify) .....  
 9 ABS 12 None used (open hole)  
 SCREEN OR PERFORATION OPENINGS ARE:  
 1 Continuous slot  Mill slot 5 Gauzed wrapped 8 Saw cut 11 None (open hole)  
 2 Louvered shutter 4 Key punched 6 Wire wrapped 9 Drilled holes  
 7 Torch cut 10 Other (specify) .....  
 SCREEN-PERFORATED INTERVALS: From ..... **9.3** ft. to ..... **19.3** ft., From ..... ft. to ..... ft.  
 From ..... ft. to ..... ft., From ..... ft. to ..... ft.  
 GRAVEL PACK INTERVALS: From ..... **7** ft. to ..... **19.3** ft., From ..... ft. to ..... ft.  
 From ..... ft. to ..... ft., From ..... ft. to ..... ft.

6 GROUT MATERIAL: 1 Neat cement  Cement grout  Bentonite 4 Other .....  
 Grout Intervals: From ..... **0** ft. to ..... **2** ft., From ..... **2** ft. to ..... **7** ft., From ..... ft. to ..... ft.  
 What is the nearest source of possible contamination:  
 1 Septic tank 4 Lateral lines 7 Pit privy  Fuel storage 14 Abandoned water well  
 2 Sewer lines 5 Cess pool 8 Sewage lagoon 12 Fertilizer storage 15 Oil well/Gas well  
 3 Watertight sewer lines 6 Seepage pit 9 Feedyard 13 Insecticide storage 16 Other (specify below)  
 Direction from well? **Southeast** How many feet? **75**

FROM	TO	LITHOLOGIC LOG	FROM	TO	PLUGGING INTERVALS
0	6"	Concrete			
6"	9'	Silty clay, light brown			Flush mount cover
9	9.5	Sand, yellow, fine			Site ID # 00094616
9.5	13	Gravelly clay, light brown			
13	14.5	Sand, light brown			
14.5	19.3	Clay, yellow to grey			

7 CONTRACTOR'S OR LANDOWNER'S CERTIFICATION: This water well was  constructed,  reconstructed, or  plugged under my jurisdiction and was completed on (mo/day/year) **10-19-92** and this record is true to the best of my knowledge and belief. Kansas Water Well Contractor's License No. **527** This Water Well Record was completed on (mo/day/yr) **10-30-92** under the business name of **GeoCore Services, Inc.** by (signature) *Doug Ray*