


1 LOCATION OF WATER WELL: County: SMITH	Fraction SW 1/4 SE 1/4 NE 1/4	Section Number 29	Township Number T 3 S	Range Number R 15 EW
---	---	-----------------------------	---------------------------------	--------------------------------

Distance and direction from nearest town or city street address of well if located within city?
IN RAILROAD ST - W of MAIN

2 WATER WELL OWNER: **KENSINGTON CU\OP**
 RR#, St. Address, Box #: **228 S MAIN KENSINGTON KS**
 City, State, ZIP Code: _____
 Board of Agriculture, Division of Water Resources
 Application Number: _____

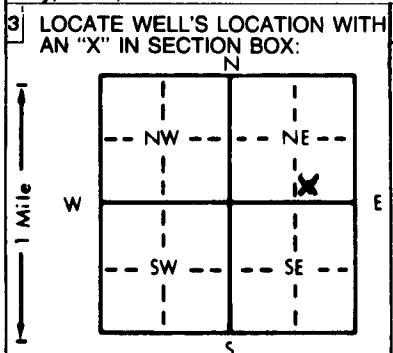

4 DEPTH OF COMPLETED WELL: **50** ft. ELEVATION: _____
 Depth(s) Groundwater Encountered 1. **39.8** ft. 2. _____ ft. 3. _____ ft.
 WELL'S STATIC WATER LEVEL: **39** ft. below land surface measured on mo/day/yr **12-16-92**
 Pump test data: Well water was **SIFTY** ft. after _____ hours pumping _____ gpm
 Est. Yield: **625** gpm; Well water was _____ ft. after _____ hours pumping _____ gpm
 Bore Hole Diameter: **7.25** in. to **50** ft., and _____ in. to _____ ft.
 WELL WATER TO BE USED AS:
 5 Public water supply 8 Air conditioning 11 Injection well
 1 Domestic 3 Feedlot 6 Oil field water supply 9 Dewatering 12 Other (Specify below)
 2 Irrigation 4 Industrial 7 Lawn and garden only 10 Monitoring well
 Was a chemical/bacteriological sample submitted to Department? Yes _____ No **X**; If yes, mo/day/yr sample was submitted _____
 Water Well Disinfected? Yes _____ No **X**

5 TYPE OF BLANK CASING USED:
 1 Steel 3 RMP (SR) 5 Wrought iron 8 Concrete tile CASING JOINTS: Glued _____ Clamped _____
 2 PVC 4 ABS 6 Asbestos-Cement 9 Other (specify below) Welded _____
 7 Fiberglass Threaded **X**
 Blank casing diameter: **2** in. to **0-29** ft. Dia. **29** in. to _____ ft. Dia. _____ in. to _____ ft.
 Casing height above land surface: **0** in. weight **SCH 40** lbs./ft. Wall thickness or gauge No. _____
 TYPE OF SCREEN OR PERFORATION MATERIAL:
 1 Steel 3 Stainless steel 5 Fiberglass 7 PVC 10 Asbestos-cement
 2 Brass 4 Galvanized steel 6 Concrete tile 8 RMP (SR) 11 Other (specify) _____
 12 None used (open hole)
 SCREEN OR PERFORATION OPENINGS ARE:
 1 Continuous slot 3 Mill slot 5 Gauzed wrapped 8 Saw cut 11 None (open hole)
 2 Louvered shutter 4 Key punched 6 Wire wrapped 9 Drilled holes
 7 Torch cut 10 Other (specify) _____
 SCREEN-PERFORATED INTERVALS: From **29** ft. to **49** ft. From _____ ft. to _____ ft.
SAND From _____ ft. to _____ ft. From _____ ft. to _____ ft.
 GRAVEL-PACK INTERVALS: From **27** ft. to **50** ft. From _____ ft. to _____ ft.
 From _____ ft. to _____ ft. From _____ ft. to _____ ft.

6 GROUT MATERIAL: 1 Neat cement 2 Cement grout 3 Bentonite 4 Other _____
 Grout Intervals: **2** From **0** ft. to **22** ft. From **22** ft. to **27** ft. From _____ ft. to _____ ft.
 What is the nearest source of possible contamination:
 1 Septic tank 4 Lateral lines 7 Pit privy 10 Livestock pens 14 Abandoned water well
 2 Sewer lines 5 Cess pool 8 Sewage lagoon 11 Fuel storage 15 Oil well/Gas well
 3 Watertight sewer lines 6 Seepage pit 9 Feedyard 12 Fertilizer storage 16 Other (specify below)
 13 Insecticide storage
 Direction from well? _____ How many feet? _____

FROM	TO	LITHOLOGIC LOG	FROM	TO	PLUGGING INTERVALS
0	1.25	ASPHALT + FILL			
1.25	15	SILTY CLAY			
15	18.75	CLAYEY SAND			
18.75	20.25	SILTY SAND			
20.25	24.25	SILTY CLAY			
24.25	29	SILT			
29	39.8	SAND - SANDY CLAY - CLAYEY SAND LENS - ODOR AT 35			
39.8	50	SAND			
		FLUSH MOUNT			

7 CONTRACTOR'S OR LANDOWNER'S CERTIFICATION: This water well was (1) constructed, (2) reconstructed, or (3) plugged under my jurisdiction and was completed on (mo/day/year) **12-01-92** and this record is true to the best of my knowledge and belief. Kansas Water Well Contractor's License No. **479** This Water Well Record was completed on (mo/day/yr) **12-22-92** under the business name of **EBBERTS DRILLING** by signature *Steven Ebberts*