


1 LOCATION OF WATER WELL: Fraction NW 1/4 SE 1/4 NE 1/4 Section Number 29 Township Number T 3 S Range Number R 15 EW
 County: SMITH

Distance and direction from nearest town or city street address of well if located within city?
EAST OF ALLEY - WEST OF MAIN N OF RAILROAD ST.

2 WATER WELL OWNER: KENSINGTON CU-OP
 RR#, St. Address, Box #: 228 S MAIN KENSINGTON KS Board of Agriculture, Division of Water Resources
 City, State, ZIP Code: Application Number:

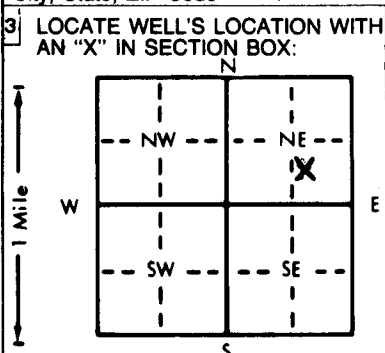

4 DEPTH OF COMPLETED WELL: 58 ft. ELEVATION:
 Depth(s) Groundwater Encountered 1. 42.1 ft. 2. ft. 3. ft.
 WELL'S STATIC WATER LEVEL 40.91 ft. below land surface measured on mo/day/yr 12-16-92
 Pump test data: Well water was VERY SILTY after FINE SAND hours pumping gpm
 Est. Yield 1.5 gpm: Well water was ft. after hours pumping gpm
 Bore Hole Diameter 7.25 in. to 52 ft., and in. to ft.
 WELL WATER TO BE USED AS:
 5 Public water supply 8 Air conditioning 11 Injection well
 1 Domestic 3 Feedlot 6 Oil field water supply 9 Dewatering 12 Other (Specify below)
 2 Irrigation 4 Industrial 7 Lawn and garden only 10 Monitoring well
 Was a chemical/bacteriological sample submitted to Department? Yes No X; If yes, mo/day/yr sample was sub-
 mitted Water Well Disinfected? Yes No X

5 TYPE OF BLANK CASING USED:
 1 Steel 3 RMP (SR) 5 Wrought iron 8 Concrete tile CASING JOINTS: Glued Clamped
2 PVC 4 ABS 6 Asbestos-Cement 9 Other (specify below) Welded
 7 Fiberglass Threaded X
 Blank casing diameter 2 in. to 30 ft., Dia in. to ft., Dia in. to ft.
 Casing height above land surface 0 in., weight SCH 40 lbs./ft. Wall thickness or gauge No.
 TYPE OF SCREEN OR PERFORATION MATERIAL:
 1 Steel 3 Stainless steel 5 Fiberglass 8 RMP (SR) 10 Asbestos-cement
 2 Brass 4 Galvanized steel 6 Concrete tile 9 ABS 11 Other (specify)
 12 None used (open hole)
 SCREEN OR PERFORATION OPENINGS ARE:
 1 Continuous slot 3 Mill slot 5 Gauzed wrapped 8 Saw cut 11 None (open hole)
 2 Louvered shutter 4 Key punched 6 Wire wrapped 9 Drilled holes
 7 Torch cut 10 Other (specify)
 SCREEN-PERFORATED INTERVALS: From 30 ft. to 50 ft., From ft. to ft.
SAND From ft. to ft., From ft. to ft.
~~GRAVEL-PACK~~ INTERVALS: From 27 ft. to 55 ft., From ft. to ft.
 From ft. to ft., From ft. to ft.

6 GROUT MATERIAL: 1 Neat cement 2 Cement grout 3 Bentonite 4 Other
 Grout Intervals: 2 From 0 ft. to 21 ft., 3 From 21 ft. to 27 ft., From ft. to ft.
 What is the nearest source of possible contamination:
 1 Septic tank 4 Lateral lines 7 Pit privy 10 Livestock pens 14 Abandoned water well
 2 Sewer lines 5 Cess pool 8 Sewage lagoon 11 Fuel storage 15 Oil well/Gas well
 3 Watertight sewer lines 6 Seepage pit 9 Feedyard 12 Fertilizer storage 16 Other (specify below)
 Direction from well? How many feet? UPGRADE FROM CONTAMINATED AREA

FROM	TO	LITHOLOGIC LOG	FROM	TO	PLUGGING INTERVALS
0	1	FILL-GRAVEL SAND			
1	16	SILTY CLAY - GRS ODOR			
16	21	CLAYEY SAND			
21	25	SILTY SAND			
25	28	SAND			
28	39	CLAY			
39	41	CLAYEY SAND			
41	55	SAND			

7 CONTRACTOR'S OR LANDOWNER'S CERTIFICATION: This water well was (1) constructed, (2) reconstructed, or (3) plugged under my jurisdiction and was completed on (mo/day/year) 11-30-92 and this record is true to the best of my knowledge and belief. Kansas Water Well Contractor's License No. 479 This Water Well Record was completed on (mo/day/yr) 12-23-92 under the business name of EBBERTS DRILLING by (signature) Morgan Eberts

INSTRUCTIONS: Use typewriter or ball point pen. PLEASE PRESS FIRMLY and PRINT clearly. Please fill in blanks, underline or circle the correct answers. Send top three copies to Kansas Department of Health and Environment, Bureau of Water, Topeka, Kansas 66620-0001. Telephone: 913-296-5545. Send one to WATER WELL OWNER and retain one for your records.